

SCOTT

~~LEASE~~

D 29

8-26-74

MISSISSIPPI BOARD OF WATER COMMISSIONERS CODED 416 North State Street Jackson, Mississippi 39201

WATER WELL DRILLERS LOG

SCOTT

8-26 1974 date well completed 74 Common Drilling Service Leasing firm name Scott county well located

LANDOWNER: LONIE DEAN Walnut Grove #1 Miss (mailing address)

description of formations encountered	from	to
	Shy	0
Sand	40	75

WELL LOCATION: sec. 3 T 8 N R 9 E 1 miles W of Sebastopol (distance) (direction) (nearest town)

WELL PURPOSE: Home (home, irrigation, municipal, industrial)

CODED

- WELL COMPLETION DATA:
- (1) diameter (inches) 2"
 - (2) total depth (feet)
 - (3) static water level (feet) 40 below top of ground.
 - (4) casing 5' steel (material), (depth) 2 (size) if telescope see back.
 - (5) screen 5' 6" (length), 6" (depth to top) 2" (size), 5' steel (material)
 - (6) pump 3/4 (HP), 6 (yield gpm) 6 (type power)
 - (7) electric log NO (yes or no)
 - (organization running log)
 - (8) how well bottom plugged

DRILLERS REMARKS:


DECEMBER 1974

OCT 1974

22 OF 100

If well telescopes please sketch and show depths.

GROUND LEVEL

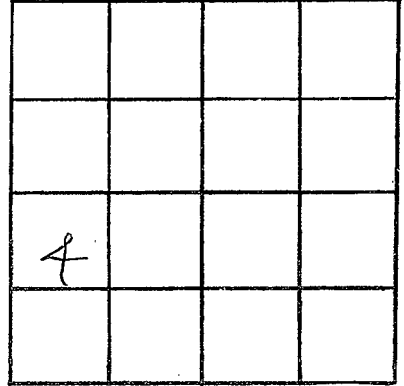

SECTION _____

Please indicate well location X.

ADDITIONAL INFORMATION

If more than one screen,
show locations of each on sketch.