

Scott
D 30
9-25-75

MISSISSIPPI
 BOARD OF WATER COMMISSIONERS
 416 North State Street
 Jackson, Mississippi 39201

WATER WELL DRILLERS LOG

CODED

9.25.75 19 McDONALD HILLS SCOTT
 date well completed firm name county well located


LANDOWNER:	description of formations encountered	from	to
<u>Choctaw utility Comm</u>	<u>Clay sand</u>	<u>0</u>	<u>35</u>
<u>Philadelph</u> (mailing address)	<u>Shale & Rock</u>	<u>35</u>	<u>60</u>
WELL LOCATION:	<u>Shale</u>	<u>60</u>	<u>100</u>
sec <u>36</u> T <u>8</u> N R <u>9</u> E 13T S W	<u>Sand & Shale</u>	<u>100</u>	<u>150</u>
<u>5</u> miles <u>SOUTH</u> of <u>SEBASTOPOL</u> (distance) (direction) (nearest town)	<u>Sand</u>	<u>150</u>	<u>250</u>
WELL PURPOSE: <u>1-0-0-0-0-0</u> (home irrigation, municipal, industrial)	<u>Sandy</u>	<u>250</u>	<u>270</u>
WELL COMPLETION DATA:	<u>Shale & Rock</u>	<u>270</u>	<u>290</u>
(1) diameter (inches) <u>4"</u>	<u>Shale</u>	<u>290</u>	<u>350</u>
(2) total depth (feet) <u>400'</u>	<u>Rock & Shale</u>	<u>350</u>	<u>370</u>
(3) static water level (feet) <u>100'</u> below top of ground.	<u>Sand</u>	<u>370</u>	<u>400</u>
(4) casing <u>PVC</u> <u>505'</u> (material) (depth)			
<u>4"</u> If telescope see back. (size)			
(5) screen _____ (length) (depth to top)			
(size) (material)			
(6) pump <u>1/2 sub</u> <u>10</u> (HP) (yield gpm)			
<u>E</u> (type power)			
(7) electric log _____ (yes or no)			
(organization running log)			
(8) how well bottom plugged <u>OPEN</u>			
DRILLERS REMARKS:			

REGISTERED
 MISS.
 OCT - 0 1975

MISS. BD. OF WATER COMMISSIONERS

If well telescopes please sketch and show depths.

GROUND LEVEL

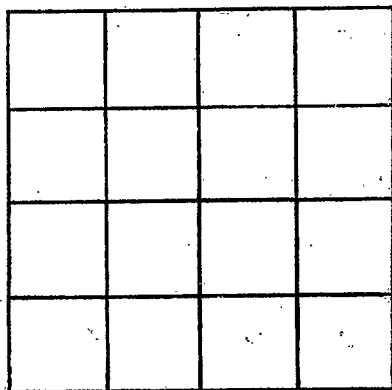

SECTION _____

Please indicate well location X.

ADDITIONAL INFORMATION

If more than one screen, show locations of each on sketch.