

SCOTT  
D 3A  
12-17-80

MISSISSIPPI  
BOARD OF WATER COMMISSIONERS  
416 North State Street  
Jackson, Mississippi 39201

CODED

WATER WELL DRILLERS LOG

12-17-1980 date well completed  
Common Drilling firm name  
Scott county well located


LANDOWNER: Green Grove Farms  
description of formations encountered  
from to  
Clay 0 30  
Clay 30 90

WELL LOCATION:  
sec. 13 T 8 N R 9 E S W  
2 miles 50 S of 5 Suburban (distance) (direction) (nearest town)

Clay 30 90  
Sand & Clay 90 130  
good sand 130 145

WELL PURPOSE: Industrial  
(home, irrigation, municipal, industrial)


WELL COMPLETION DATA:  
(1) diameter (inches) 4 1/2  
(2) total depth (feet) 145  
(3) static water level (feet) 4 below top of ground  
(4) casing PVC, 130 (material) (depth)  
(size) If telescope see back.  
(5) screen 10, 130 (length) (depth to top)  
2" Stainless Steel (size) (material)  
(6) pump 1, 25 (HP) (yield gpm)  
E (type power)  
(7) electric log NO (yes or no)  
(organization running log)  
(8) how well bottom plugged BAW

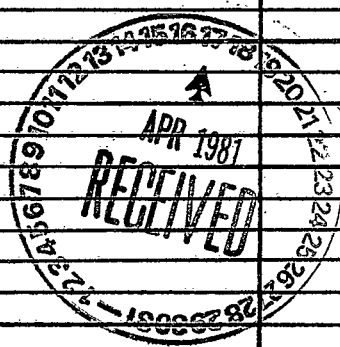

DRILLERS REMARKS:

If well telescopes please sketch and show depths.

GROUND LEVEL

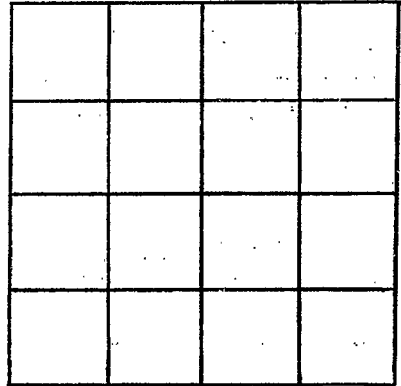

SECTION \_\_\_\_\_

Please indicate well location X.

ADDITIONAL INFORMATION

If more than one screen,  
show locations of each on sketch.