

Scott
D 2002
2-15-77

MISSISSIPPI
BOARD OF WATER COMMISSIONERS
416 North State Street
Jackson, Mississippi 39201

13T

WATER WELL DRILLERS LOG

2-15 date well completed 1977 firm name County well located

LANDOWNER: T. B. Kethart
W. B. G. G. G. G. G.
Miss.
(mailing address)

description of formations encountered	from	to
Clay	0	30
Sand + Clay	30	60
Sand	60	90

WELL LOCATION:
sec B T 8 N S R 9 E W
X 2+ miles W of Sherwood
(distance) (direction) (nearest town)

WELL PURPOSE: Dom
(home, irrigation, municipal, industrial)


- WELL COMPLETION DATA:
- (1) diameter (inches) 4"
 - (2) total depth (feet) 90
 - (3) static water level (feet) 30 below above top of ground.
 - (4) casing PVC 80
(material) (depth)
(size) if telescope see back.
 - (5) screen 10 80
(length) (depth to top)
2" PVC
(size) (material)
 - (6) pump 3/4 15
(HP) (yield gpm)
E
(type power)
 - (7) electric log NO
(yes or no)
(organization running log)
 - (8) how well bottom plugged B-W

DRILLERS REMARKS:

RECEIVED
MAY 9 1977
MISS. BD. OF WATER

If well telescopes please sketch and show depths.

GROUND LEVEL

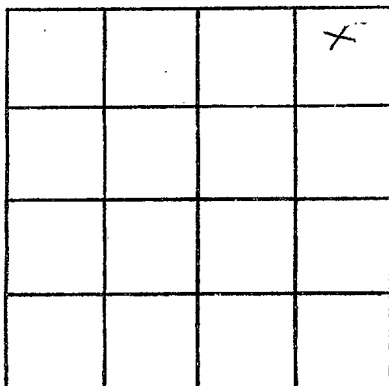

SECTION _____

Please indicate well location X.

ADDITIONAL INFORMATION

If more than one screen,
show locations of each on sketch.