

SCOTT
D 2003
2/10/78

MISSISSIPPI
BOARD OF WATER COMMISSIONERS
416 North State Street
Jackson, Mississippi 39201

WATER WELL DRILLERS LOG

2-10-78 date well completed
McDonald & Hill firm name
Scott county well located

LANDOWNER:	description of formations encountered	from	to
Robert King	clay + sand	0	35
Box 21, Sebastopol (mailing address)	shale	35	40
WELL LOCATION:	clay + sand	40	46
sec. 31 T 8 N R 9 E	shale	46	55
6 miles SW of Sebastopol (distance) (direction) (nearest town)	sandy shale st Rock	55	80
WELL PURPOSE: home (home, irrigation, municipal, industrial)	shale	80	90
WELL COMPLETION DATA:	sandy shale st Rock	90	110
(1) diameter (inches) 4"	sand + shale	110	170
(2) total depth (feet) 440'	sand	170	190
(3) static water level (feet) 132' below top of ground.	shale	190	205
(4) casing PVC 3 1/2" (material) (depth)	sand	205	290
4" if telescope see back. (size)	sandy shale	290	340
(5) screen (length) (depth to top)	shale	340	392
(size) (material)	rock & shells	392	425
(6) pump 3/4 HP 6000 (HP) (yield gpm)	sand	425	440
(type power) E			
(7) electric log (yes or no)			
(organization running log)			
(8) how well bottom plugged open			
DRILLERS REMARKS:			


RECEIVED

FEB 21 1978

MISS. BD. OF WATER COMMISSIONERS

If well telescopes please sketch and show depths.

GROUND LEVEL

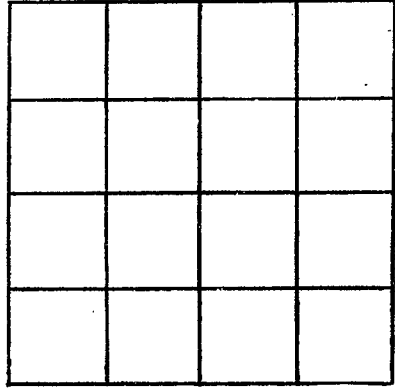

SECTION _____

Please indicate well location X.

ADDITIONAL INFORMATION

If more than one screen, show locations of each on sketch.