

Scott
D 2005
Jan. 9, 1979

MISSISSIPPI
 BOARD OF WATER COMMISSIONERS
 416 North State Street
 Jackson, Mississippi 39201

WATER WELL DRILLERS LOG

1-9-79 19 Common Drilling Service Scott
 date well completed firm name county well located

LANDOWNER: J.H. Latham
Walnut Grove Rd MS
 (mailing address)
 WELL LOCATION:
 sec. 3 T 8 N 9 E
 S W
1/2 miles W of Selstad
 (distance) (direction) (nearest town)
 WELL PURPOSE: Home
 (home, irrigation, municipal, industrial)

description of formations encountered	depth	
	from	to
Clay	0	30
Sand & Clay	30	170
Clay	170	220
Clay & Silt	220	255
Green Sand	255	300

WELL COMPLETION DATA:
 (1) diameter (inches) 3 1/2
 (2) total depth (feet) 300
 (3) static water level (feet) 80' below top of ground.
 (4) casing PVC 210
 (material) (depth)
 (size) If telescope see back.
 (5) screen Alum
 (length) (depth to top)
 (size) (material)
 (6) pump 1/2 HP 5
 (HP) (yield gpm)
E
 (type power)
 (7) electric log NO
 (yes or no)
 (organization running log)
 (8) how well bottom plugged

Miss. Board of Water Comm.


JUL 18 1979

RECEIVED

DRILLERS REMARKS:

If well telescopes please sketch and show depths.

GROUND LEVEL

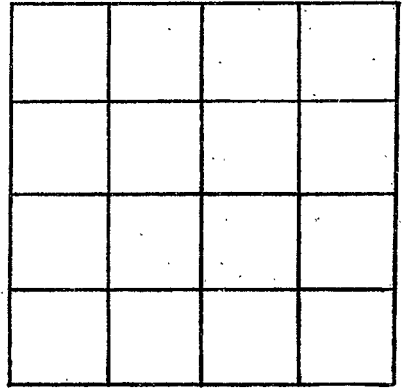

SECTION _____

Please indicate well location X.

ADDITIONAL INFORMATION

If more than one screen, show locations of each on sketch.