

South

D 2000

3-6-80

3-6-80

MISSISSIPPI  
 BOARD OF WATER COMMISSIONERS  
 416 North State Street  
 Jackson, Mississippi 39201

WATER WELL DRILLERS LOG

19 1980 Common Drilling Co South  
 date well completed firm name county well located

LANDOWNER: L.H. Lathan  
Walnut Grove Rd 1  
MS  
 (mailing address)

WELL LOCATION:  
 sec 5 T 8 R 90  
3 miles North Shelby  
 (distance) (direction) (nearest town)

WELL PURPOSE: Home  
 (home, irrigation, municipal, industrial)

- WELL COMPLETION DATA:
- (1) diameter (inches) 9"
  - (2) total depth (feet) 420
  - (3) static water level (feet) 130 below above top of ground.
  - (4) casing Metal 336  
 (material) (depth)  
 (size) If telescope see back.
  - (5) screen None  
 (length) (depth to top)  
 (size) (material)
  - (6) pump 1 1/2 4  
 (HP) (yield gpm)  
Electric  
 (type power)
  - (7) electric log NO  
 (yes or no)  
 (organization running log)
  - (8) how well bottom plugged


description of formations encountered	depth	
	from	to
<u>0-40 Clay</u>	<u>0</u>	<u>40</u>
<u>Fine Sand</u>	<u>40</u>	<u>55</u>
<u>Dark Sand</u>	<u>55</u>	<u>108</u>
<u>Sandy Silt</u>	<u>108</u>	<u>155</u>
<u>Gray Clay</u>	<u>155</u>	<u>216</u>
<u>Silt</u>	<u>216</u>	<u>280</u>
<u>Sandy Rock</u>	<u>280</u>	<u>305</u>
<u>Sand</u>	<u>305</u>	<u>330</u>
<u>Clay</u>	<u>330</u>	<u>380</u>
<u>Rock &amp; Silt</u>	<u>380</u>	<u>405</u>
<u>Sand</u>	<u>405</u>	<u>420</u>

DRILLERS REMARKS:

DEPT. OF NATURAL RESOURCES  
 BUREAU OF LAND & WATER  
 RECEIVED  
 JUL 23 1980

If well telescopes please sketch and show depths.

GROUND LEVEL

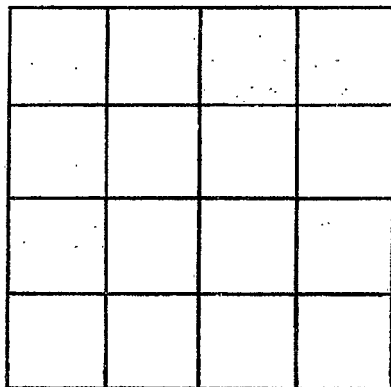

SECTION \_\_\_\_\_

Please indicate well location X.

ADDITIONAL INFORMATION

If more than one screen, show locations of each on sketch.