

MISSISSIPPI DEPARTMENT OF NATURAL RESOURCES

Bureau of Land and Water Resources

P.O. Box 10631

Jackson, Mississippi 39209

WATER WELL DRILLERS LOG

COUNTY WELL LOCATED SCOTT	
WELL NUMBER D	CODED
DATE WELL COMPLETED 2007 11-17-87	

PERMIT NUMBER 0-474
NAME OF DRILLING FIRM GARDNER DRILLING SERVICE

NAME & MAILING ADDRESS OF LANDOWNER HORVAI JONES			
RT. 1 BOX 69			
WALNUT GROVE, MS 39159			
WELL LOCATION:	SEC	TOWNSHIP	RANGE
	20	8N	9 E
DISTANCE	DIRECTION	NEAREST TOWN	
4 Miles	S	of SEBASTOPOL	
OTHER LANDMARK			
WELL PURPOSE: <u>Home</u> , Irrigation, Municipal, Industrial, Fish Pond, etc.			

PUMP DATA		
PUMP TYPE (Circle One): <input checked="" type="radio"/> Submersible, Turbine, Jet, Flowing Well, Other (Describe) _____		
POWER TYPE (Circle One): <input checked="" type="radio"/> Electric, Tractor, Diesel, Gasoline, Butane, Other (Describe) _____		
Pump Capacity (GPM) 20	No. of Stages 11	Setting Depth 105 FT.
PUMP TEST		
Well yielded 20 GPM with a drawdown of 20 ft. after 12 hours of pumping		

WELL DATA		
Well Depth 415'	Casing Diameter (In.) 4"	Casing Length (Ft.) 303
Type of Casing PVC	Hole Depth 415'	Depth to Static Water Level 50'
TYPE OF COMPLETION: (Circle One or More): Gravel Packed, Underreamed, Telescoped, Natural Development, <input checked="" type="radio"/> Open Hole, Other (Describe) _____		
Top of Lap Pipe or Reduction in Casing		
FEET	IF TELESCOPED OR MORE THAN ONE SCREEN: USE BACK PAGE	

LOG DATA	
TYPE OF LOG RUN (Circle One): Electric, Gamma Ray, Density, Sonic, <input checked="" type="radio"/> No Log Run, Neutron, Other (Describe) _____	
Name of Organization Running Log	

SCREEN DATA		
Diameter - Inches	Length - Feet	Slot Size - Inches
_____	_____	_____
Screen Type	Depth to Bottom - Feet	
_____	_____	

GEOLOGIC DATA (Office Use Only)			
Surface Elev.	Geologic Unit	Unit Thickness	Depth to Top
Subs. SWL	Date	Analysis	Aquifer Test
Driller's Remarks			

DESCRIPTION OF FORMATIONS ENCOUNTERED	FROM	TO	FORMATIONS (Continued)	FROM	TO
YELLOW CLAY SAND	0	10	CLAY SAND	10	20
SAND & SHELL ROCK	20	35	SAND & ROCK LEDGES	35	415
SAND	35	36			
CLAY SAND	36	90			
SAND	90	100			
ROCK	100	215			
Lign NITE	215	217			
CLAY SAND	217	240			
SHELL	240	320			
	320	350			


JUN 16 1988

Department of Natural Resources
Bureau of Land & Water Resources

IF MORE SPACE IS NEEDED, USE BACK

If well telescopes please sketch and show depths.

GROUND LEVEL

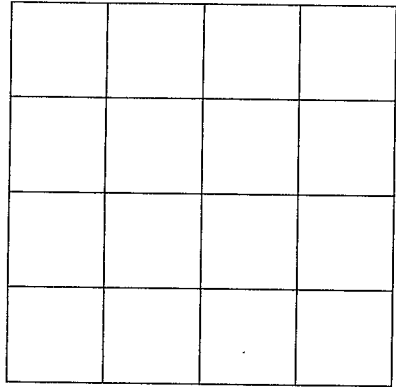

SECTION _____

Please indicate well location X.

ADDITIONAL INFORMATION

If more than one screen, show location of each on sketch.