

MISSISSIPPI DEPARTMENT OF NATURAL RESOURCES

Bureau of Land and Water Resources

P.O. Box 10631

Jackson, Mississippi 39209

WATER WELL DRILLERS LOG

COUNTY WELL LOCATED SCOTT	
WELL NUMBER D	CODED
DATE WELL COMPLETED 2008 6-28-88	

PERMIT NUMBER 0-474
NAME OF DRILLING FIRM GARDNER DRILLING

NAME & MAILING ADDRESS OF LANDOWNER KENNETH THRASH			
RT. 1			
WALNUT GROVE, MS. 39457			
WELL LOCATION:	SEC	TOWNSHIP	RANGE
	23	8	9
		N	E
		S	W
DISTANCE	DIRECTION	NEAREST TOWN	
4 Miles	SOUTH	SEBRISTOBI	
OTHER LANDMARK			
WELL PURPOSE: <u>Home</u> , Irrigation, Municipal, Industrial, Fish Pond, etc.			

PUMP DATA		
PUMP TYPE (Circle One): <u>Submersible</u> , Turbine, Jet, Flowing Well, Other (Describe) _____		
POWER TYPE (Circle One): <u>Electric</u> , Tractor, Diesel, Gasoline, Butane, Other (Describe) _____		
Pump Capacity (GPM)	No. of Stages	Setting Depth
14	10	147 FT.
PUMP TEST		
Well yielded 14 GPM with a drawdown of 20 ft. after 24 hours of pumping		

WELL DATA		
Well Depth 345	Casing Diameter (In.) 4"	Casing Length (Ft.) 230
Type of Casing PVC	Hole Depth 345	Depth to Static Water Level 86'
TYPE OF COMPLETION: (Circle One or More): Gravel Packed, Underreamed, Telescoped, Natural Development, <u>Open Hole</u> , Other (Describe) _____		
Top of Lap Pipe or Reduction in Casing		
FEET	IF TELESCOPED OR MORE THAN ONE SCREEN: USE BACK PAGE	

LOG DATA	
TYPE OF LOG RUN (Circle One): No Log Run, Electric, Gamma Ray, Density, Sonic, Neutron, Other (Describe) _____	
Name of Organization Running Log	


SCREEN DATA		
Diameter - Inches	Length - Feet	Slot Size - Inches
Screen Type	Depth to Bottom - Feet	

GEOLOGIC DATA (Office Use Only)			
Surface Elev.	Geologic Unit	Unit Thickness	Depth to Top
Subs. SWL	Date	Analysis	Aquifer Test
Driller's Remarks			

DESCRIPTION OF FORMATIONS ENCOUNTERED	FROM	TO	FORMATIONS (Continued)	FROM	TO
CLAY	0	10	<div style="font-size: 2em; font-weight: bold; border: 2px solid black; padding: 5px; display: inline-block;">RECEIVED</div> <div style="font-size: 1.5em; font-weight: bold;">FEB 9 1989</div> <div style="font-size: 0.8em;">Department of Natural Resources Bureau of Land & Water Resources</div>		
CLAY & SAND LEGS	10	40			
SAND	40	180			
Lig NITE SAND	180	200			
ROCK	200	202			
SAND	202	210			
ROCK	210	212			
CLAY	212	260			
Shell	260	280			
SAND	280	340			
CLAY	340	345			
IF MORE SPACE IS NEEDED, USE BACK					

If well telescopes please
sketch and show depths.

GROUND LEVEL

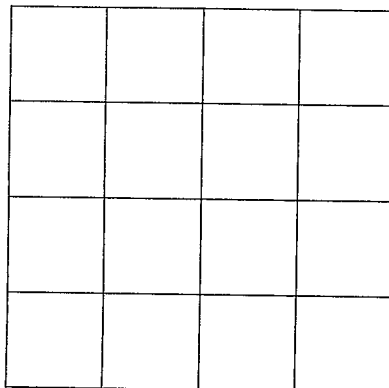

SECTION _____

Please indicate well location X.

ADDITIONAL INFORMATION

If more than one screen,
show location of each on sketch.