

SCOTT

3 E 2 T
10-5-62

WATER WELL DRILLERS LOG

7

Date: 10-5, 1962, Driller: Newton Riley, Sr. County: Scott
(Name)

(1) Owner of Land: Polie Lee Riley
(Name)
R3 Marton, Miss
(Address)

(2) Location: 1/4, 1/4, Sec. 23 7 6 T. R.
2 miles South of Fortville
(distance) (direction) (Nearest Town)

(3) Topography: Flat
(Hilly) (Flat) (Level)

(4) Purpose of Well: Domestic
(Domestic Irrigation
Municipal, Industrial, Other)

Description & Color of Materials Sand, Clay, Red Clay, Shell, etc.	Thick- ness Feet	Depth Feet
0-70 Hard clay	0	70
Red	2	72
Blue clay	68	140
Clay sand	5	145
Clay	5	150
fine tight sand	10	160
clay	10	170
Dark grey sand	20	190
Clay	4	194
Dark grey sand	86	280
Grey sand	48	328

Information upon completion of well:

(1) Diameter 2 inches.

(2) Total Depth 328 1/2 feet.

(3) Water Level 72 feet below top of ground.

(4) Cased to _____, Size _____


(5) Screen: Size 2 1/2", Length 5'
Galv. Steel

(6) Were any formations sealed against pollution?
_____ yes, _____ no.

If YES depth of formation _____

Why _____

Drillers Remarks: air free
Producing better
than 1200 gallons
per hour

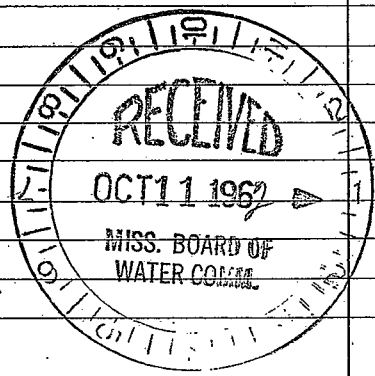

(Use Back Side)

Well No.

[The page contains extremely faint and illegible text, likely bleed-through from the reverse side of the document. The text is scattered across the page and cannot be transcribed accurately.]