

E4 T
8-30-62

WATER WELL DRILLERS LOG

6

Date: Aug 30, 1962, Driller: Roy Wilkerson County Scott
(Name)

(1) Owner of Land: John Gaydon
(Name)
Jackson, Miss
(Address)

(2) Location: 1/4, 1/4, Sec. 3 T 7R6,
11 miles N. of Meriden
(distance) (direction) (Nearest Town)

(3) Topography: Hilly
(Hilly) (Flat) (Level)

(4) Purpose of Well: Domestic
(Domestic Irrigation
Municipal, Industrial, Other)

Description & Color of Materials Sand, Clay, Red Clay, Shell, etc.	Thick- ness Feet	Depth Feet
<u>Yellow Clay</u>	<u>10</u>	
<u>Grey silt</u>	<u>10</u>	
<u>Bluish silt</u>	<u>30</u>	
<u>Dark Sand</u>	<u>10</u>	
<u>Grey Sand</u>	<u>20</u>	
<u>Dark Clay</u>	<u>50</u>	
<u>Dark Sand</u>	<u>20</u>	
<u>Blue silt</u>	<u>10</u>	
<u>Fine sandy clay</u>	<u>66</u>	
<u>Water Sand</u>	<u>60</u>	

Information upon completion of well:

(1) Diameter 2 inches.

(2) Total Depth 306 feet.

(3) Water Level 65 feet below top of ground.

(4) Cased to 306 ft, Size 2"


(5) Screen: Size 2", Length 12"

(6) Were any formations sealed against pollution?
yes, no.

If YES depth of formation _____

Why _____

Drillers Remarks: _____

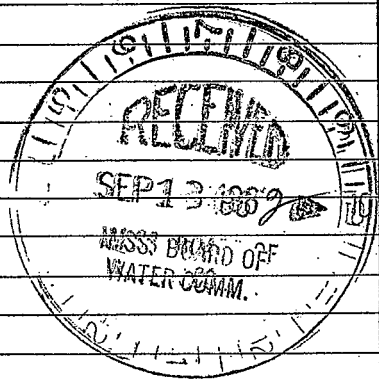

(Use Back Side)

Well No.

Please send me
some envelopes -

Thanks

Roy Wilkerson