


3
E S T
10-27-61

WATER WELL DRILLERS LOG

E K

Date: 10/27, 1961, Driller: Johnnie Beasley County Scott
(Name)

	Description & Color of Materials Sand, Clay, Red Clay, Shell, etc.	Thick- ness Feet	Depth Feet
(1) Owner of Land: <u>Bill Bates</u> (Name)	Red clay.	0-	25
<u>R. F. D. Morton, Miss.</u> (Address)	Blue clay.	25-	123
(2) Location: <u>1/4</u> , <u>1/4</u> , Sec. <u>19</u> T <u>R</u>	Lime, coal & shale.	123-	164
<u>6</u> miles <u>North</u> of <u>Morton</u> (distance) (direction) (Nearest Town)	Blue clay.	164-	205
(3) Topography: <u>X</u> (Hilly) (Flat) (Level)	Shale & sandy morral.	205-	225
(4) Purpose of Well: <u>Domestic.</u> (Domestic Irrigation Municipal, Industrial, Other)	Fine sand & stks. shale.	225-	246
Information upon completion of well:	Soft clay.	246-	321
(1) Diameter <u>2"</u> inches.	Shale & stks. sand.	321-	327
(2) Total Depth <u>390'</u> feet.	Sand & stks. shale.	327-	340
(3) Water Level <u>120</u> feet below top of ground.	Shale.	340-	354
(4) Cased to <u>380'</u> , Size <u>2"</u>	Fine sand.	354-	368
(5) Screen: Size <u>2"</u> , Length <u>10'</u>	Sand. (Screen setting)	368-	390
(6) Were any formations sealed against pollution? <u>yes</u> , <u>X</u> no.			
If YES depth of formation _____			
Why _____			
Drillers Remarks: <u>Good well.</u>			

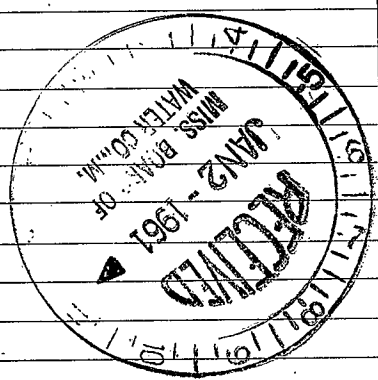

(Use Back Side)

Well No.

11
12
13
100