

SCOTT
E 6 7
7-2-60

WATER WELL DRILLERS LOG

E 302 3

Date: 7/2, 1960, Driller: James McGee County Scott
(Name)

(1) Owner of Land: Raz Gibbons
(Name)
Morton, Miss.
(Address)
(2) Location: 1/4, 1/4, Sec. 19 T 1 R 1
8 miles north, of Morton
(distance) (direction) (Nearest Town)
(3) Topography: X
(Hilly) (Flat) (Level)
(4) Purpose of Well: Domestic
(Domestic Irrigation
Municipal, Industrial, Other)

Description & Color of Materials Sand, Clay, Red Clay, Shell, etc.	Thick- ness Feet	Depth Feet
Brown Clay.	0	25
Blue Clay.	25	72
Clay & Stks. Lime.	72	82
Clay.	82	112
Clay & Stks. Lime Rock	112	122
Clay.	122	142
Clay & Stks. Lime Rock	142	146
Sandy Shell.	146	172
Fine Sand.	172	179
Clay.	179	192


Information upon completion of well:

(1) Diameter 2 inches.
(2) Total Depth 398 feet.
(3) Water Level 130 feet below top of ground.
(4) Cased to 388', Size 2"
(5) Screen: Size 2", Length 10'
(6) Were any formations sealed against pollution?
_____ yes, _____ no.

Mucky Clay & Stks.		
Sand.	192	222
Fine Sand.	222	252
Fine Sand & Stks. Clay	252	262
Clay.	262	282
Clay & Stks. Sand.	282	302
Clay.	302	344
Fine Sand.	344	378
Sand. (Screen Set)	378	398

If YES depth of formation _____
Why _____

Drillers Remarks: Good well

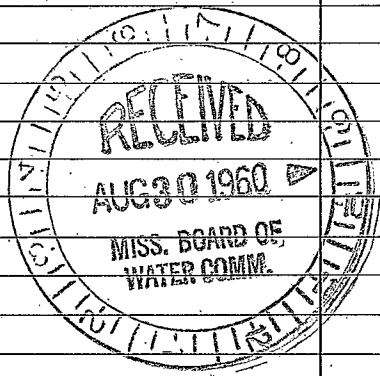

(Use Back Side)

Well No.

