

*Scott*  
 4 E 7  
 7-67

MISSISSIPPI  
 BOARD OF WATER COMMISSIONERS  
 416 North State Street  
 Jackson, Mississippi 39201

WATER WELL DRILLERS LOG

7-21 1967 *Scott Drilling* *Scott*  
 date well completed firm name county well located

LANDOWNER: *Colon Measles*

description of formations encountered from to

*Rt 2*  
*Merston, Miss.*  
 (mailing address)


*Brown Clay* 0 24  
*Blue Clay* 21 81  
*Blue Clay + 5th Limestone* 107 122  
*Clay* 122 143  
*Clay + Sandy Shell* 143 184  
*Clay + 5th Limestone* 184 204  
*Clay + 5th Limestone* 204 224  
*Clay + 5th Limestone* 224 244  
*Clay + 5th Limestone* 244 307  
*Clay + 5th Limestone* 307 327  
*Clay + 5th Limestone* 327 387  
*Clay + 5th Limestone* 387 404  
*Clay + 5th Limestone* 404 436  
*Clay + 5th Limestone* 436 470  
*Clay + 5th Limestone* 470 490

WELL LOCATION:  
 sec. *24* T. *7* N. R. *5E*  
 S. E.  
 1 miles *East* of *Leesburg*  
 (distance) (direction) (nearest town)

WELL PURPOSE: *Home*  
 (home, irrigation, municipal, industrial)

WELL COMPLETION DATA:


- (1) diameter (inches) 2"
- (2) total depth (feet) 435
- (3) static water level (feet) 70 below above top of ground.
- (4) casing Galv. 435  
 (material) (depth)  
2" if telescope see back.  
 (size)
- (5) screen 15 ft 420  
 (length) (depth to top)  
2" Clm brass  
 (size) (material)
- (6) pump \_\_\_\_\_  
 (HP) (yield gpm)  
 (type power)
- (7) electric log no  
 (yes or no)  
 (organization running log)
- (8) how well bottom plugged Water

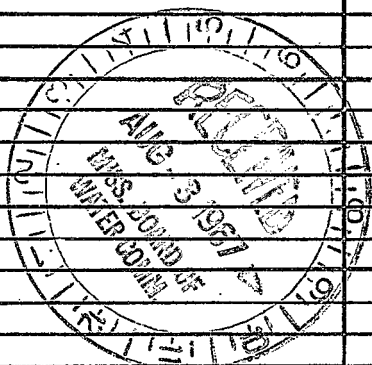

DRILLERS REMARKS:

If well telescopes please sketch and show depths.

GROUND LEVEL

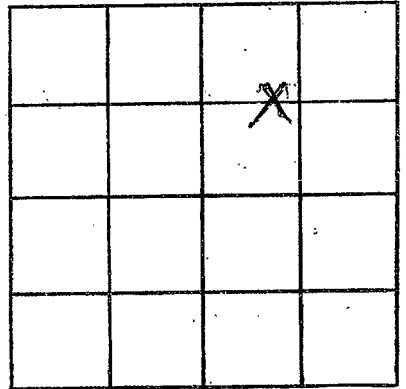

SECTION 24

Please indicate well location X.

ADDITIONAL INFORMATION

If more than one screen,  
show locations of each on sketch.