

Scott
4 E 8
9-66

MISSISSIPPI BOARD OF WATER COMMISSIONERS

11

WATER WELL DRILLERS LOG

Date: 9/12, 1966, Driller: Forest Drilling county Scott
(Name)

(1) Owner of Land: H. J. Minton
(Name)
Rt 3 Minton, Miss
(Address)

(2) Location: SW 1/4, SW 1/4, Sec 6, T7N, R6E
8 miles North, of Minton.
(distance) (direction) (Nearest Town)

(3) Topography: (Hilly) (Flat) (Level)

(4) Purpose of Well: Home
(Domestic Irrigation, Municipal, Industrial, Other)

| Description & Color of Materials Sand, Clay, Red Clay, Shell, etc. | Thick- ness Feet | Depth Feet |
|---|------------------------|---------------|
| Brown Clay | 25 | 25 |
| Blue Clay | 19 | 34 |
| Green Sand | 03 | 37 |
| Clay + Shell | 25 | 62 |
| Clay + Sth. Mly Sand | 21 | 83 |
| Clay | 60 | 143 |
| Clay + Sth. Mly Sand | 20 | 163 |
| fine sand + Sth. Clay | 21 | 184 |
| Clay | 21 | 205 |
| Clay + Sth. f. Sand | 22 | 227 |
| fine sand + Clay | 30 | 307 |
| fine sand | 22 | 329 |
| fine sand | 15 | 346 |

Information upon completion of well:

(1) Diameter 2 inches.

(2) Total Depth 346 feet.

(3) Water Level 65 feet below top of ground.

(4) Cased to 336, Size 2"


(5) Screen: Size 2", Length 10ft

(6) Were formations sealed against pollution?
 yes, no.

If YES depth of formation _____

Why _____

Drillers Remarks: _____

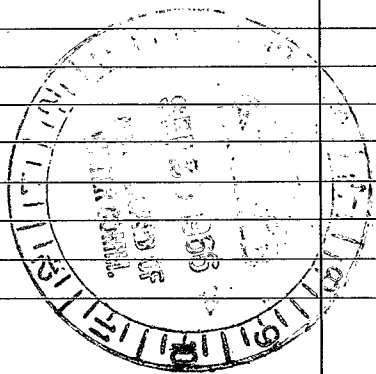

(Use Back Side)

Well No.

