

SCOTT MISSISSIPPI BOARD OF WATER COMMISSIONERS

1 E9 T
11-8-63

WATER WELL DRILLERS LOG

Date: 11/8, 1963, Driller: Frank Drilling See County Belt
(Name)


(1) Owner of Land: W.J. Masells
(Name)
St. merton Miss.
(Address)
(2) Location: 1/4, 1/4, Sec. 6 T R
at Branch Masells
miles, of Ston
(distance) (direction) (Nearest Town)
(3) Topography: X
(Hilly) (Flat) (Level)
(4) Purpose of Well: Home
(Domestic Irrigation
Municipal, Industrial, Other)

Description & Color of Materials Sand, Clay, Red Clay, Shell, etc.	Thick- ness Feet	Depth Feet
<u>Brown</u>	<u>0</u>	<u>25</u>
<u>Blue clay</u>		<u>102</u>
<u>Clay + shaly sand</u>		<u>128</u>
<u>Clay + rock</u>		<u>132</u>
<u>Clay</u>		<u>142</u>
<u>fine sand</u>		<u>202</u>
<u>Clay</u>		<u>258</u>
<u>fine sand</u>		<u>280</u>
<u>fine sand shaly</u>		<u>309</u>
<u>fine sand</u>		<u>320</u>
<u>Clay</u>		<u>325</u>
<u>fine sand</u>		<u>348</u>

Information upon completion of well:

(1) Diameter 2 inches.
(2) Total Depth 347 feet.
(3) Water Level 86 feet below top of ground.
(4) Cased to 337, Size 2"
(5) Screen: Size 2, Length 10 ft.
(6) Were any formations sealed against pollution?
no.

If YES depth of formation _____
Why _____
Drillers Remarks: _____

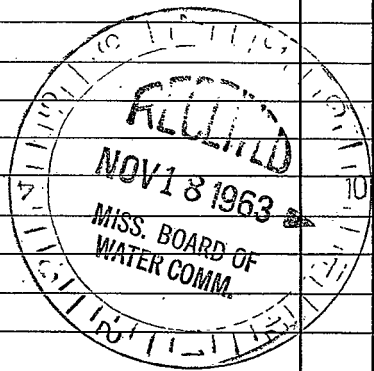

Well No.

(Use Back Side)

