

SCOTT MISSISSIPPI BOARD OF WATER COMMISSIONERS

E 10 T

7-10-65

WATER WELL DRILLERS LOG

Date: 7/10, 1965, Driller: Forest Drilling Co. Inc.
(Name)

(1) Owner of Land	Description & Color of Materials Sand, Clay, Red Clay, Shell, etc.	Thick- ness Feet	Depth Feet
<u>Mrs Ruth Neaville</u> (Name) <u>Rt 2 Boston, Miss</u> (Address)	<u>Brown Clay</u>	<u>0</u>	<u>27</u>
	<u>Blue Clay</u>		<u>68</u>
	<u>Thin Rock</u>		<u>72</u>
(2) Location: <u>1/4</u> , <u>1/4</u> , Sec. <u>32 7^N 16^E</u> <u>5 1/2</u> miles <u>North</u> of <u>Leahurst</u> (distance) (direction) (Nearest Town)	<u>B. Clays & thin rock</u>		<u>82</u>
	<u>Blue Clay</u>		<u>138</u>
	<u>Rock</u>		<u>140</u>
(3) Topography: <u>Level</u> (Hilly) (Flat) (Level)	<u>Sandy Shell</u>		<u>152</u>
	<u>Clay + S. Shell</u>		<u>162</u>
(4) Purpose of Well: <u>Home</u> (Domestic Irrigation Municipal, Industrial, Other)	<u>Clay + Mky. Sand</u>		<u>172</u>
	<u>Thin Sand</u>		<u>177</u>
	<u>Clay</u>		<u>182</u>
	<u>Clay Mky Sand</u>		<u>202</u>
	<u>Clay</u>		<u>212</u>
	<u>Fine Sand</u>		<u>222</u>
	<u>Clay + thin Mky Sand</u>		<u>252</u>
	<u>Clay + thin Mky Sand</u>		<u>262</u>
	<u>Clay + thin Mky Sand</u>		<u>282</u>
	<u>Thin Sand + thin Clay</u>		<u>356</u>
	<u>Fine Sand</u>		<u>370</u>
	<u>Fair Sand & Clay</u>		<u>386</u>
	<u>Fair Sand</u>		<u>396</u>

Information upon completion of well:

(1) Diameter 2" inches.

(2) Total Depth 396 feet.

(3) Water Level 109ft feet below top of ground.

(4) Cased to 386, Size 2"


(5) Screen: Size 2", Length 10ft

(6) Were any formations sealed against pollution?
 yes, no.

If YES depth of formation _____

Why _____

Drillers Remarks: _____

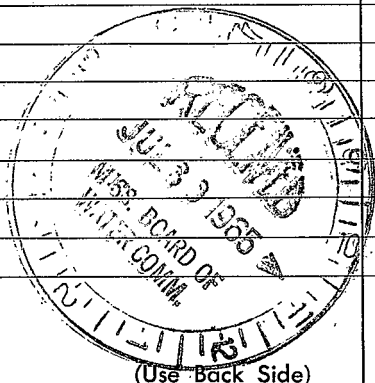

(Use Back Side)

Well No.

