

SCOTT

E 11

6-1-62

WATER WELL DRILLERS LOG

Date: 6/1, 19 62, Driller: FOREST DRILLING SERVICE County: Scott  
 231 Highway 35 North  
 FOREST, MISSISSIPPI

(1) Owner of Land: R. S. Nett  
 (Name)  
Jarvisville, Miss.  
 (Address)

(2) Location: 1/4, 1/4, Sec. 14 TN 6E  
14 T R  
1/4 miles \_\_\_\_\_, of Jarvisville  
 (distance) (direction) (Nearest Town)

(3) Topography: X  
 (Hilly) (Flat) (Level)

(4) Purpose of Well: Home use  
 (Domestic Irrigation  
 Municipal, Industrial, Other)

Description & Color of Materials Sand, Clay, Red Clay, Shell, etc.	Thick- ness Feet	Depth Feet
<u>Brown Clay</u>	<u>0</u>	<u>28</u>
<u>Clay &amp; Shell</u>	<u>16</u>	<u>42</u>
<u>Clay &amp; Sandy Shell</u>	<u>10</u>	<u>52</u>
<u>Clay &amp; Sth. Sand</u>	<u>90</u>	<u>142</u>
<u>Clay</u>	<u>10</u>	<u>152</u>
<u>Clay &amp; Sth. fine Sand</u>	<u>42</u>	<u>194</u>
<u>Fine Sand</u>	<u>16</u>	<u>210</u>
<u>Fine Sand &amp; Sth. Clay</u>	<u>23</u>	<u>233</u>
<u>Fine Sand</u>	<u>27</u>	<u>260</u>

Information upon completion of well:

(1) Diameter 2" inches.

(2) Total Depth 260 feet.

(3) Water Level 61 feet below top of ground.

(4) Cased to 252, Size 2"


(5) Screen: Size 2", Length 10 ft.

(6) Were any formations sealed against pollution?  
 \_\_\_\_\_ yes, X no.

If YES depth of formation \_\_\_\_\_

Why \_\_\_\_\_

Drillers Remarks: \_\_\_\_\_

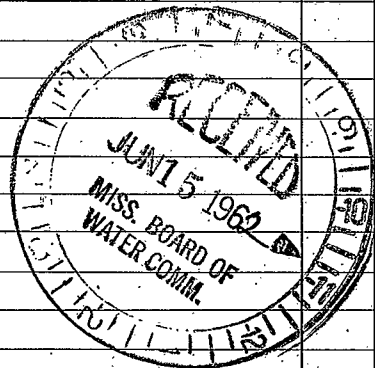

(Use Back Side)

Well No.

