

SCOTT MISSISSIPPI BOARD OF WATER COMMISSIONERS

SE 12 X
5-29-63

WATER WELL DRILLERS LOG

Date: 5/29, 1963, Driller: Faust Drilling Co., County: Scott

(1) Owner of Land: Jack Armstrong
(Name)
Jacksonville, Miss.
(Address)

(2) Location: 1/4, 1/4, Sec. 14 T. 7N R. 6E
miles North of Newton
(distance) (direction) (Nearest Town)

(3) Topography: (Level)
(Hilly) (Flat)

(4) Purpose of Well: Chicken
(Domestic Irrigation, Municipal, Industrial, Other)

Description & Color of Materials Sand, Clay, Red Clay, Shell, etc.	Thick- ness Feet	Depth Feet
Brown Clay		28
Blue Clay		42
Clay + Sh. Mdy Sand		52
Sandy Shell + Clay		62
Clay + Sh. Rock		72
Clay		82
Clay + Sh. Rock		92
Clay		126
Clay + Fine Sand		132
Fine Sand		148
Clay		162
Clay + Sh. Sand		172
Fine Sand + Sh. Clay		182
Fine Sand		202
Fine Sand		223
Clay + Sh. Sand		242
Clay		252
Clay + Mdy Sand		277
Fine Sand		322
Fine Sand		342
Clay		370
Rock		372
Clay + Sh. Rock		382
Clay		440
Clay + Fine Sand		444
Fine Sand + Sh. Clay		474
Clay + Sh. Sand		484
Clay + Fine Sand		524
Fine Sand + Sh. Clay		534
Clay + Sh. Sand		540
Fine Sand		564
Fine Sand		574
Shale		634

Information upon completion of well:

(1) Diameter 2" inches.

(2) Total Depth 574 feet.

(3) Water Level 120 feet below top of ground.

(4) Cased to 559, Size 2"


(5) Screen: Size 2", Length 15 ft.

(6) Were any formations sealed against pollution?
no

If YES depth of formation _____

Why _____

Drillers Remarks: _____

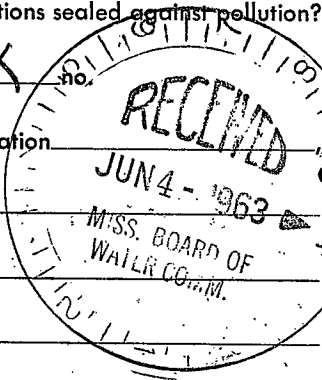

(Use Back Side)

Well No.

