

SCOTT MISSISSIPPI BOARD OF WATER

E 14  
9-24-62

WATER WELL DRILLERS LOG

Date: 9/24, 1962, Driller: Frost Drilling County Katt  
(Name)


(1) Owner of Land: Ed P. Pruitt  
(Name)  
Marston Miss.  
(Address)  
(2) Location: 1/4, 1/4, Sec. 2 T 7N R 6E  
1 1/2 miles North of Fordville  
(distance) (direction) (Nearest Town)  
(3) Topography: X  
(Hilly) (Flat) (Level)  
(4) Purpose of Well: Home use  
(Domestic Irrigation  
Municipal, Industrial, Other)

Description & Color of Materials Sand, Clay, Red Clay, Shell, etc.	Thick- ness Feet	Depth Feet
<u>Brown Clay</u>		<u>30</u>
<u>Blue Clay</u>		<u>42</u>
<u>Clay + Shls. Rock</u>		<u>62</u>
<u>Shly Sand + Clay</u>		<u>82</u>
<u>Rock</u>		<u>84</u>
<u>Clay</u>		<u>152</u>
<u>Clay + Shls Rock</u>		<u>172</u>
<u>fine sand</u>		<u>182</u>
<u>fine Clay, Shls sand</u>		<u>208</u>
<u>fine sand</u>		<u>232</u>
<u>fair sand</u>		<u>246</u>
<u>Clay</u>		<u>248</u>
<u>fine sand</u>		<u>252</u>
<u>Clay + Shls sand</u>		<u>264</u>
<u>Good sand</u>		<u>283</u>

Information upon completion of well:

(1) Diameter 2" inches.  
(2) Total Depth 283 feet.  
(3) Water Level 60 feet below top of ground.  
(4) Cased to 273, Size 2"  
(5) Screen: Size 2", Length 10 ft  
(6) Were any formations sealed against pollution?  
no

If YES depth of formation \_\_\_\_\_  
Why \_\_\_\_\_  
Drillers Remarks: \_\_\_\_\_

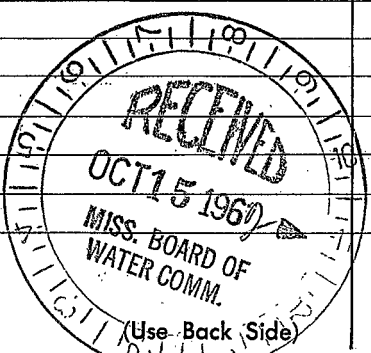

Well No.

