

SCOTT
E 15
5-16-63

WATER WELL DRILLERS LOG

8

Date: 5/16, 1963, Driller: Frank Belguss County Scott
(Name)

(1) Owner of Land M. L. Lindsey
(Name)

Rt 2 Norton Miss
(Address)

(2) Location: 1/4, 1/4, Sec 26 7N 6E T R
(distance) (direction) (Nearest Town)

5 miles North of Norton
(distance) (direction) (Nearest Town)

(3) Topography: X
(Hilly) (Flat) (Level)

(4) Purpose of Well: Home
(Domestic Irrigation, Municipal, Industrial, Other)

Description & Color of Materials Sand, Clay, Red Clay, Shell, etc.	Thick- ness Feet	Depth Feet
<u>Brown Clay</u>	<u>0</u>	<u>27</u>
<u>Blue Clay</u>		<u>62</u>
<u>Clay</u>		<u>92</u>
<u>Clay & 1/4th fine sand</u>		<u>102</u>
<u>Clay</u>		<u>132</u>
<u>Clay & 1/4th Rock</u>		<u>142</u>
<u>Sandy Shell</u>		<u>162</u>
<u>Med. Sand + Clay</u>		<u>222</u>
<u>Clay</u>		<u>312</u>
<u>Clay & 1/4th Sand</u>		<u>325</u>
<u>Fine Sand</u>		<u>332</u>
<u>Clay & 1/4th Sand</u>		<u>352</u>
<u>Fine Sand</u>		<u>382</u>
<u>Fine Sand</u>		<u>420</u>

Information upon completion of well:

(1) Diameter 2" inches.

(2) Total Depth 420 feet.

(3) Water Level 126 feet below top of ground.

(4) Cased to 410, Size 2"


(5) Screens: Size 2", Length 10 ft.

(6) Were any formations sealed against pollution?
X yes, X no.

If YES depth of formation _____

Why _____

Drillers Remarks: _____

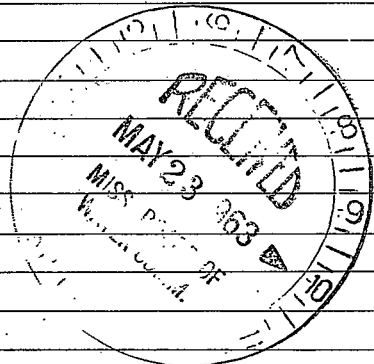

(Use Back Side)

Well No.

