

SCOTT MISSISSIPPI BOARD OF WATER COMMISSIONERS

E/6
6-27-66

WATER WELL DRILLERS LOG

Date: 6/27, 19 66 Driller: Forest Drilling County: Scott
(Name)

(1) Owner of Land: Henry E. Kerch
(Name)
Box 167 - Morton, Miss
(Address)

(2) Location: 1/4, 1/4, Sec. 21 NE T. 11 R. 11
8 miles North of Morton
(distance) (direction) (Nearest Town)

(3) Topography: ✓
(Hilly) (Flat) (Level)

(4) Purpose of Well: Arne
(Domestic Irrigation
Municipal, Industrial, Other)

Description & Color of Materials Sand, Clay, Red Clay, Shell, etc.	Thick- ness Feet	Depth Feet
<u>yellow clay</u>	<u>0</u>	<u>30</u>
<u>Blue clay</u>	<u>10</u>	<u>5</u>
<u>Soft clay & silt</u>	<u>2</u>	<u>46</u>
<u>Silt sand</u>	<u>2</u>	<u>57</u>
<u>Shell</u>	<u>2</u>	<u>72</u>
<u>Fine sand</u>	<u>3</u>	<u>18</u>

Information upon completion of well:

(1) Diameter 2 inches.

(2) Total Depth 318 feet.

(3) Water Level 98 feet below top of ground.

(4) Cased to 308, Size 2"


(5) Screen: Size 2", Length 10 ft.

(6) Were any formations sealed against pollution?
✓ yes, ✓ no.

If YES depth of formation _____

Why _____

Drillers Remarks: _____

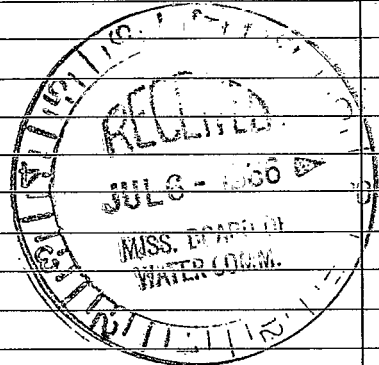

(Use Back Side)

Well No.

[The page contains extremely faint and illegible text, likely bleed-through from the reverse side of the document. No specific words or phrases can be discerned.]