

**WATER WELL DRILLERS LOG**

E 187  
4-66

Date: April, 1966, Driller: Roy Wilkerson County Scott  
Lake, Miss (Name)

(1) Owner of Land: mitchel Clark  
(Name)  
Morton, Miss  
(Address)

(2) Location: 1/4, 1/4, Sec. 35 <sup>11/16 E</sup> T R  
4 miles N of Morton  
(distance) (direction) (Nearest Town)

(3) Topography: Level  
(Hilly) (Flat) (Level)

(4) Purpose of Well: Cattle Fann  
(Domestic Irrigation  
Municipal, Industrial, Other)

Description & Color of Materials Sand; Clay, Red Clay, Shell, etc.	Thick- ness Feet	Depth Feet
<u>Dandy Top Soil</u>	<u>20</u>	
<u>Blue Clay</u>	<u>100</u>	
<u>Rocky</u>	<u>107</u>	
<u>Fine Sand</u>	<u>50</u>	
<u>Water Sand</u>	<u>50</u>	<u>327</u>

**Information upon completion of well:**

(1) Diameter 2 inches.

(2) Total Depth 327 feet.

(3) Water Level 97 feet below top of ground.

(4) Cased to 327, Size 2


(5) Screen: Size 2, Length 12

(6) Were any formations sealed against pollution?  
     yes,      no.

If YES depth of formation \_\_\_\_\_

Why \_\_\_\_\_

Drillers Remarks: \_\_\_\_\_

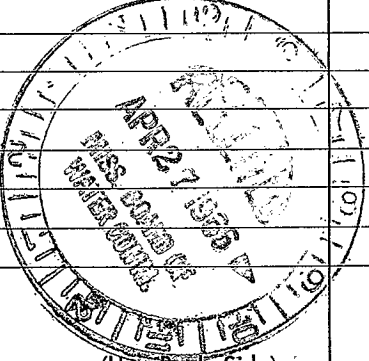

Well No.

