

SCOTT MISSISSIPPI BOARD OF WATER COMMISSIONERS

6 E 19 T

10-8-65

WATER WELL DRILLERS LOG

Date: 10/8, 1965, Driller: Forest Drilling Co. Scott  
 (Name)

(1) Owner of Land: W. H. Thompson  
 (Name)  
Morton, Miss.  
 (Address)

(2) Location: 1/4, 1/4, Sec 13 T R  
6 miles North, of Morton  
 (distance) (direction) (Nearest Town)

(3) Topography:  (Hilly)  (Flat)  (Level)

(4) Purpose of Well: Home  
 (Domestic Irrigation, Municipal, Industrial, Other)

Description & Color of Materials Sand, Clay, Red Clay, Shell, etc.	Thick- ness Feet	Depth Feet
Green Clay		24
Blue Clay		82
Clay + shls (unbed)		92
Blue Clay		122
Clay + Rock		132
Rock + Shells		142
Clay + sandy Shells		182
Soft Shale		192
Fine sand		202
F. sand + shls Clay		212
Clay + shls + sand		222
Soft Shale		242
Shale		319
Shls + shls + sand		329
Shale		339
Fine sand		349
F. sand + Clay		359
F. sand + shls Clay		399
Fine sand		404
Fine sand + clay		419
Fine sand		429
Fine sand		435

Information upon completion of well:

(1) Diameter 7 inches.

(2) Total Depth 435 feet.

(3) Water Level 96 feet below top of ground.

(4) Cased to 425, Size 2"


(5) Screen: Size 2", Length 10ft

(6) Were any formations sealed against pollution?  
 yes,  no.

If YES depth of formation \_\_\_\_\_

Why \_\_\_\_\_

Drillers Remarks: \_\_\_\_\_

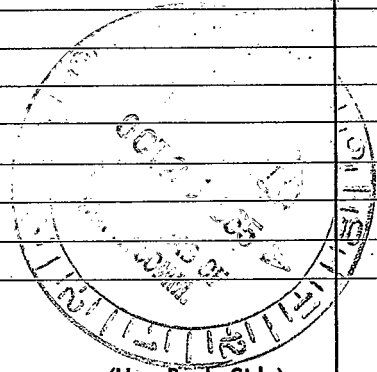

(Use Back Side)

Well No.

