

SCOTT MISSISSIPPI BOARD OF WATER COMMISSIONERS

6 E22 T
1-11-65

WATER WELL DRILLERS LOG

Date: 1/11, 1965, Driller: Forest Drilling Co., County: Scott


(Name)

(1) Owner of Land:	Description & Color of Materials Sand, Clay, Red Clay, Shell, etc.	Thick- ness Feet	Depth Feet
George Palmer (Name)	Brown clay	0	29
Rt 3 Lewis Miss (Address)	blue clay		42
711 1/2	Clay + fine rock		52
(2) Location: 1/4, 1/4, Sec. 7 T. R.	Clay + shell		72
10 miles n/w. of Morton (distance) (direction) (Nearest Town)	Clay + paper sand		82
(3) Topography: <input checked="" type="checkbox"/> (Hilly) <input type="checkbox"/> (Flat) <input type="checkbox"/> (Level)	Soft clay		132
(4) Purpose of Well: Home (Domestic Irrigation Municipal, Industrial, Other)	Clay + soft fine sand		172
	fine sand		247
	fine sand + pebbles		260
	fine sand		294
	fine sand		351

Information upon completion of well:

- (1) Diameter 2 inches.
- (2) Total Depth 351 feet.
- (3) Water Level 46 feet below top of ground.
- (4) Cased to 336, Size 2"
- (5) Screen: Size 2", Length 15ft
- (6) Were any formations sealed against pollution?
 yes, no.

If YES depth of formation _____
 Why _____
 Drillers Remarks: _____

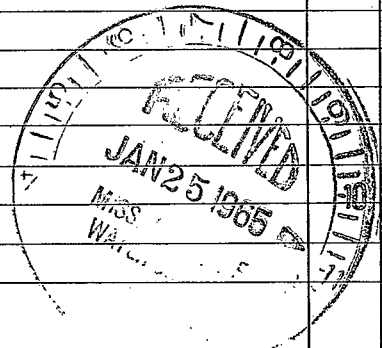

(Use Back Side)

Well No.

