

SCOTT MISSISSIPPI BOARD OF WATER COMMISSIONERS

6 E23 T  
1-2-65 WATER WELL DRILLERS LOG

Date: 1/2, 1965, Driller: Forest Dilling, County: Scott  
(Name)

(1) Owner of Land: Jeff Gray  
(Name)  
Newton, Miss.  
(Address)

(2) Location: 1/4, 1/4, Sec. 19 T 7N R 6E  
6 miles North, of Newton  
(distance) (direction) (Nearest Town)

(3) Topography:  (Hilly)  (Flat)  (Level)

(4) Purpose of Well: Home  
(Domestic Irrigation, Municipal, Industrial, Other)

Description & Color of Materials Sand, Clay, Red Clay, Shell, etc.	Thick- ness Feet	Depth Feet
Brown clay		23
Blue Clay		102
Clay + shells lime rock		142
Clay		152
Clay + Rock		162
Clay + Shells		182
Clay + Shells		192
Clay + Shells fine sand		212
Clay		272
Clay + Shells fine sand		232
Fine sand + shells clay		242
Clay		262
Fine sand		270
Fine sand + Clay		282
Clay		339
Clay + Shells		349
Clay		369
Fine sand + Shells Clay		379
Clay		392
Fine sand		419

Information upon completion of well:

(1) Diameter 2 inches.

(2) Total Depth 414 feet.

(3) Water Level 74 feet below top of ground.

(4) Cased to 399, Size 2"


(5) Screen: Size 2", Length 15ft

(6) Were any formations sealed against pollution?  
 yes,  no.

If YES depth of formation \_\_\_\_\_

Why \_\_\_\_\_

Drillers Remarks: \_\_\_\_\_

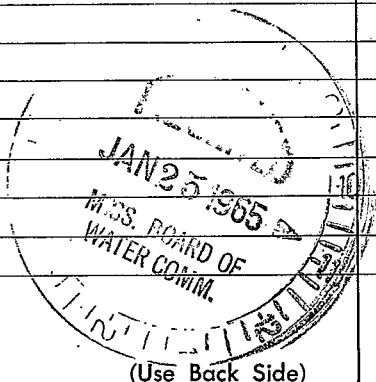

Well No. \_\_\_\_\_

