

6 E 25 T
10-7-64

WATER WELL DRILLERS LOG

Date: 10/7, 1964, Drillers: Forest Drilling County Scott
(Name)

(1) Owner of Land: Wayne Fairchild
(Name)
Rt 2 Morton, Miss
(Address)
(2) Location: 1/4, 1/4, Sec 18 T 7 N R 6 E
8 miles North of Morton
(distance) (direction) (Nearest Town)
(3) Topography: Level
(Hilly) (Flat) (Level)
(4) Purpose of Well: Home
(Domestic Irrigation
Municipal, Industrial, Other)


Description & Color of Materials Sand, Clay, Red Clay, Shell, etc.	Thick- ness Feet	Depth Feet
<u>Brown Clay</u>	<u>0</u>	<u>24</u>
<u>Clay + Lime Rock</u>		<u>32</u>
<u>Clay</u>		<u>142</u>
<u>Clay + 1/4" Fine Sand</u>		<u>182</u>
<u>Sand + Clay</u>		<u>242</u>
<u>Fine Sand</u>		<u>272</u>

Information upon completion of well:

(1) Diameter 2 inches.
(2) Total Depth 272 feet.
(3) Water Level 40 feet below top of ground.
(4) Cased to 262', Size 2"
(5) Screen: Size 2", Length 10ft
(6) Were any formations sealed against pollution?
_____ yes, X no.

If YES depth of formation _____
Why _____

Drillers Remarks: _____

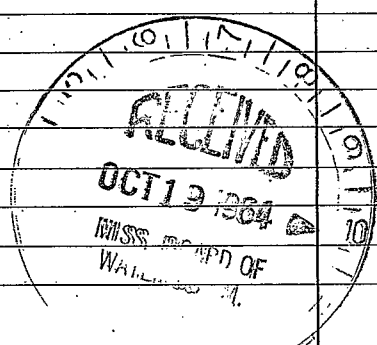

(Use Back Side)

Well No.

