

SCOTT MISSISSIPPI BOARD OF WATER COMMISSIONERS

6 E 26 T
9-23-64

WATER WELL DRILLERS LOG

Date: 9/23, 1964, Driller: Trust Drilling Co County Scott
(Name)

(1) Owner of Land: L. Minton
(Name)
Rt 3, Minton, Miss
(Address)

(2) Location: 1/4, 1/4, Sec 18 T 6E R 1
8 miles North, of Minton
(distance) (direction) (Nearest Town)

(3) Topography: (Level)
(Hilly) (Flat)

(4) Purpose of Well: Home
(Domestic Irrigation, Municipal, Industrial, Other)

Description & Color of Materials Sand, Clay, Red Clay, Shell, etc.	Thick- ness Feet	Depth Feet
<u>Brown Clay</u>	<u>0</u>	<u>24</u>
<u>Green Clay</u>		<u>25</u>
<u>Blue Clay</u>		<u>42</u>
<u>Clay</u>		<u>102</u>
<u>Clay & Sh. Sand</u>		<u>122</u>
<u>Clay + Sh. Sand</u>		<u>142</u>
<u>Clay</u>		<u>198</u>
<u>Clay & Sh. Sand</u>		<u>222</u>
<u>7 Sand + Sh. Clay</u>		<u>242</u>
<u>7 Sand</u>		<u>268</u>
<u>7 Sand</u>		<u>278</u>
<u>Clay</u>		<u>288</u>
<u>7 Sand</u>		<u>292</u>
<u>7 Sand + Sh. Clay</u>		<u>314</u>
<u>7 Sand</u>		<u>314</u>
<u>Fair Sand</u>		<u>334</u>

Information upon completion of well:

(1) Diameter 2 inches.

(2) Total Depth 330 feet.

(3) Water Level 65 feet below top of ground.

(4) Cased to 315, Size 2"


(5) Screen: Size 2", Length 15ft

(6) Were any formations sealed against pollution?
 yes, no.

If YES depth of formation _____

Why _____

Drillers Remarks: _____

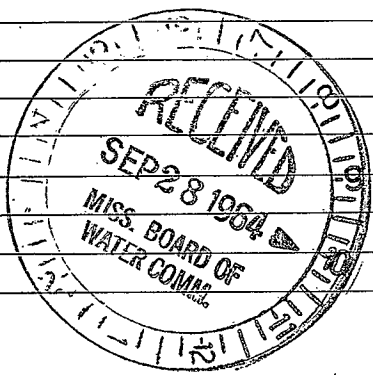

(Use Back Side)

Well No.

