

E27
9-23-63

WATER WELL DRILLERS LOG

Date: 9/23, 1963, Driller: Forest Dwyer County: Scott
(Name)

(1) Owner of Land: Mr. Joe Bates
(Name)
RFB Morton
(Address)

(2) Location: 1/4, 1/4, Sec. 29 T. 7N R. 6E
5 miles North of Morton
(distance) (direction) (Nearest Town)

(3) Topography: X
(Hilly) (Flat) (Level)

(4) Purpose of Well: Home
(Domestic Irrigation, Municipal, Industrial, Other)

Description & Color of Materials Sand, Clay, Red Clay, Shell, etc.	Thick- ness Feet	Depth Feet
<u>Brown Clay</u>	<u>0</u>	<u>27</u>
<u>Blue Clay</u>		<u>112</u>
<u>Clay + Sth. Rock</u>		<u>122</u>
<u>Sandy Shell</u>		<u>132</u>
<u>Clay + Sth. ground</u>		<u>152</u>
<u>Shale</u>		<u>162</u>
<u>Shale + Mdy Sand</u>		<u>202</u>
<u>Fine Sand</u>		<u>212</u>
<u>Fine Sand + Sth. Clay</u>		<u>232</u>
<u>Shale</u>		<u>262</u>
<u>Fine Sand + Sth. Clay</u>		<u>282</u>
<u>Fine Sand</u>		<u>320</u>
<u>Fine Sand</u>		<u>380</u>

Information upon completion of well:

(1) Diameter 2 inches.

(2) Total Depth 372 feet.

(3) Water Level 87 feet below top of ground.


(4) Cased to 357, Size 2"

(5) Screen: Size 2", Length 15ft.

(6) Were any formations sealed against pollution?
_____ yes, X no.

If YES depth of formation _____
Why _____

Drillers Remarks: _____

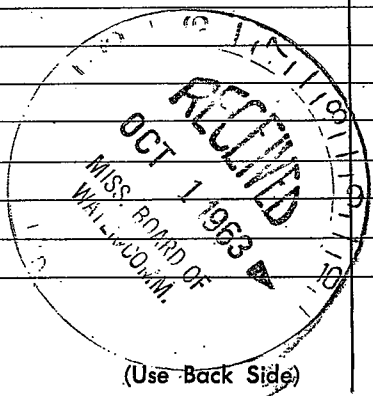

Well No.

[The page contains extremely faint and illegible text, likely bleed-through from the reverse side of the document. No specific words or phrases can be discerned.]