

SCOTT MISSISSIPPI BOARD OF WATER COMMISSIONERS

6 E 28
8-29-63

WATER WELL DRILLERS LOG

Date: 8/29, 1963, Driller: Faust Dwyer, County: Scott


(1) Owner of Land: G.J. Fran
(Name)
Rehatchie, Miss.
(Address)
(2) Location: 1/4, 1/4, Sec. 1 T 7th SE R
10 miles North of Norton
(distance) (direction) (Nearest Town)
(3) Topography: X
(Hilly) (Flat) (Level)
(4) Purpose of Well: Home
(Domestic Irrigation
Municipal, Industrial, Other)

| Description & Color of Materials Sgnd, Clay, Red Clay, Shell, etc. | Thick- ness Feet | Depth Feet |
|---|------------------------|---------------|
| Brown Clay | 0 | 32 |
| Blue Clay | | 162 |
| Sandy shell | | 192 |
| very sand & clay | | 222 |
| fine sand | | 232 |
| Clay & sh. fine sand | | 262 |
| Clay | | 272 |
| fine sand | | 282 |
| fine sand & sh. clay | | 302 |
| fine sand | | 322 |
| Clay & sh. sand | | 347 |
| Clay | | 357 |
| fair sand | | 377 |

Information upon completion of well:

(1) Diameter 2" inches.
(2) Total Depth 377 feet.
(3) Water Level 107 feet below top of ground.
(4) Cased to 267, Size 2"
(5) Screen: Size 2", Length 10ft.
(6) Were any formations sealed against pollution?
yes, X no.

If YES depth of formation _____
Why _____
Drillers Remarks: _____

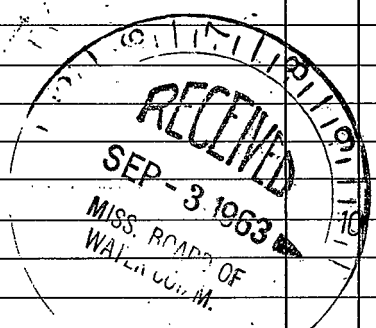

(Use Back Side)

Well No.

