

SCOTT MISSISSIPPI BOARD OF WATER COMMISSIONERS

WATER WELL DRILLERS LOG

Date: 8/7, 1963, Driller: Frank DeGard County Scott
 (Name)


(1) Owner of Land: C. L. Hamill
 (Name)
Morton, Miss
 (Address)
 (2) Location: 1/4, 1/4, Sec 19 T R
6 miles North of Morton
 (distance) (direction) (Nearest Town)
 (3) Topography: X
 (Hilly) (Flat) (Level)
 (4) Purpose of Well: Home
 (Domestic Irrigation
 Municipal, Industrial, Other)

Description & Color of Materials Sand, Clay, Red Clay, Shell, etc.	Thick- ness Feet	Depth Feet
Brown Clay	0	27
Blue clay		62
Clay & shls rock		82
Clay		132
Clay & shls rock		142
Sandy shell + rock		162
Clay		202
shly sand + clay		232
clay + shly sand		252
shale		272
Fine sand + clay		282
Fine sand + shls clay		292
Fine sand		302
Fine sand		325
Good sand		339

Information upon completion of well:

(1) Diameter 2 inches.
 (2) Total Depth 339 feet.
 (3) Water Level 100 feet below top of ground.
 (4) Cased to 229, Size 2"
 (5) Screen: Size 2", Length 10 ft
 (6) Were any formations sealed against pollution?
 _____ yes, X no.

If YES depth of formation _____
 Why _____
 Drillers Remarks: _____

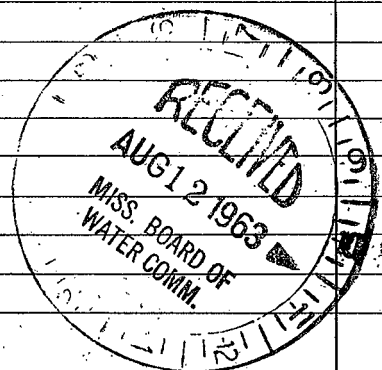

(Use Back Side)

Well No.

