

SCOTT
E 30
52-63

WATER WELL DRILLERS LOG

Date: 5/2, 1963, Driller: First Drlg. Co. County: Scott
(Name)

(1) Owner of Land: Latham Ave
(Name)
Shively, Miss.
(Address)

(2) Location: 1/4, 1/4, Sec 17 T R
8 miles North of Winton
(distance) (direction) (Nearest Town)

(3) Topography: (Hilly) (Flat) (Level)

(4) Purpose of Well: Home
(Domestic Irrigation
Municipal, Industrial, Other)

Description & Color of Materials Sand, Clay, Red Clay, Shell, etc.	Thick- ness Feet	Depth Feet
<u>Chalk</u>	<u>0</u>	<u>30</u>
<u>Blue Clay</u>		<u>90</u>
<u>Fine Sand + Shale</u>		<u>110</u>
<u>Shale</u>		<u>144</u>
<u>Soft Shale</u>		<u>164</u>
<u>Silt Sand + Shale</u>		<u>205</u>
<u>Silt + Shale</u>		<u>225</u>
<u>Fine Sand</u>		<u>271</u>

Information upon completion of well:

(1) Diameter 2" inches.

(2) Total Depth 271 feet.

(3) Water Level 69 feet below top of ground.


(4) Cased to 261, Size 2"

(5) Screen: Size 2", Length 10 ft.

(6) Were any formations sealed against pollution?
 yes, no.

If YES depth of formation _____
Why _____

Drillers Remarks: _____

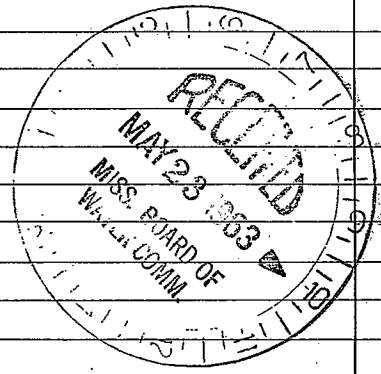

(Use Back Side)

Well No.

