

SCOTT  
E 33 T  
8-23-60

WATER WELL DRILLERS LOG

6300

Date: 8/23, 1960, Driller: James McGee County: Scott.  
(Name)

(1) Owner of Land: Wyatt Measells  
(Name)  
Forest, Miss.  
(Address)

(2) Location: 1/4, 1/4, Sec. 17 1 N 6 E T. R.  
8 miles North of Morton  
(distance) (direction) (Nearest Town)

(3) Topography: X  
(Hilly) (Flat) (Level)

(4) Purpose of Well: Domestic  
(Domestic Irrigation  
Municipal, Industrial, Other)

Description & Color of Materials Sand, Clay, Red Clay, Shell, etc.	Thick- ness Feet	Depth Feet
Brown clay.	0	22
Red sand & clay.	22	26
Mucky sand & Clay.	26	38
Clay.	38	52
Fine sand & clay.	52	72
Clay & stks. sand.	72	102
Clay.	102	122
Fine sand & stks. clay	122	132
Fine Sand.	132	157
Clay.	157	177
Fine sand.	177	273
Good sand.	273	288

Information upon completion of well:

(1) Diameter 2 inches.

(2) Total Depth 288 feet.

(3) Water Level 33 feet below top of ground.


(4) Cased to 276', Size 2"

(5) Screen: Size 2", Length 15'

(6) Were any formations sealed against pollution?  
no yes, X no.

If YES depth of formation \_\_\_\_\_  
Why \_\_\_\_\_

Drillers Remarks: Good well.

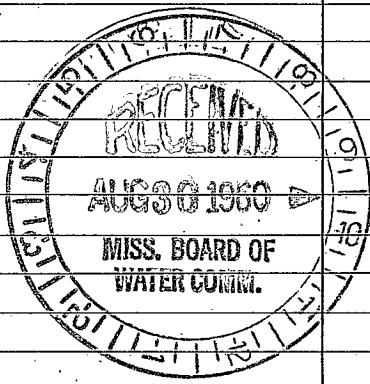

(Use Back Side)

Well No.

