

CODED

CODED

SCOTT
E 42
11-12-69

MISSISSIPPI
BOARD OF WATER COMMISSIONERS
416 North State Street
Jackson, Mississippi 39201

WATER WELL DRILLERS LOG

11-12 1969 Forest Drilling Scott
date well completed firm name county well located


LANDOWNER:	description of formations encountered	from	to
(mailing address)			
Billy Minton Brazoria, Miss. Rt. 3 Merton, Miss.	Brown clay	0	26
	Blue clay	26	60
	Clay + shell	60	102
	Clay, silts, limestone	102	122
	Clay + silt	122	184
	Clay + silts fine sand	184	304
	Clay	304	307
	Clay + silts fine sand	307	343
	fine sand	343	365
	Clay	365	368
WELL LOCATION:			
sec. <u>1</u> T. <u>7</u> N. R. <u>5</u> E. # <u>1</u>			
<u>9</u> miles <u>N</u> of <u>Merton</u>			
(distance) (direction) (nearest town)			
WELL PURPOSE: <u>home</u> (home, irrigation, municipal, industrial)			
WELL COMPLETION DATA:			
(1) diameter (inches) <u>2"</u>			
(2) total depth (feet) <u>365'</u>			
(3) static water level (feet) <u>78'</u> below above top of ground.			
(4) casing <u>Steel</u> , <u>350'</u> (material) (depth)			
<u>2"</u> if telescope see back. (size)			
(5) screen <u>15'</u> , <u>350'</u> (length) (depth to top)			
<u>2"</u> , <u>Brass #1008</u> (size) (material)			
(6) pump <u>3 HP COMP-20211</u> (HP) (yield gpm)			
<u>Electric</u> (type power)			
(7) electric log <u>no</u> (yes or no)			
(organization running log)			
(8) how well bottom plugged <u>2" Backwash Valve</u>			
DRILLERS REMARKS:			

JAN 9 1970

MISS. Bd. OF WATER COMMISSIONERS

If well telescopes please sketch and show depths.

GROUND LEVEL

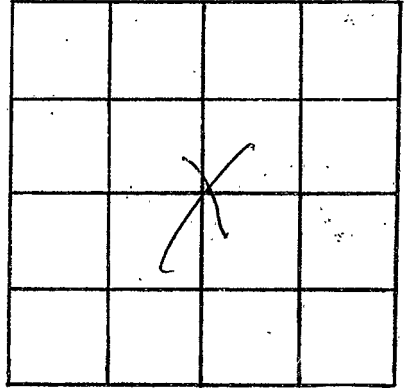

SECTION 1

Please indicate well location X.

ADDITIONAL INFORMATION

If more than one screen,
show locations of each on sketch.