

MISSISSIPPI  
BOARD OF WATER COMMISSIONERS  
416 North State Street  
Jackson, Mississippi 39201

**CODED**

WATER WELL DRILLERS LOG

SCOTT  
E 43  
6-28-71

June 28 1971 Walker Drilling Serv Scott  
date well completed firm name county well located

LANDOWNER: Cecil Register  
Morton, Miss  
(mailing address)

description of formations encountered	from	to
yellow clay	0'	10'
Blue clay	10'	40'
yellow clay	40'	60'
B. clay & rock	60'	146'
fine sand	146'	325'
Water B. sand.	325'	355'

WELL LOCATION:  
sec. 35 T 7 N R 6 E  
6 miles in direction of Morton  
(distance) (direction) (nearest town)

WELL PURPOSE: Home  
(home, irrigation, municipal, industrial)

- WELL COMPLETION DATA:
- (1) diameter (inches) 2"
  - (2) total depth (feet) 355'
  - (3) static water level (feet) 126 below above top of ground.
  - (4) casing galv. 355'  
(material) (depth)  
\_\_\_\_\_ If telescope see back.  
(size)
  - (5) screen 5' \_\_\_\_\_  
(length) (depth to top)  
2" S. Steel  
(size) (material)
  - (6) pump \_\_\_\_\_ (HP) \_\_\_\_\_ (yield gpm)  
Elec.  
(type power)
  - (7) electric log \_\_\_\_\_  
(yes or no)  
\_\_\_\_\_  
(organization running log)
  - (8) how well bottom plugged B.W.V.

**CODED**


JUL 6 1971

MISS. BD. OF  
WATER COMM.

DRILLERS REMARKS:

If well telescopes please sketch and show depths.

GROUND LEVEL

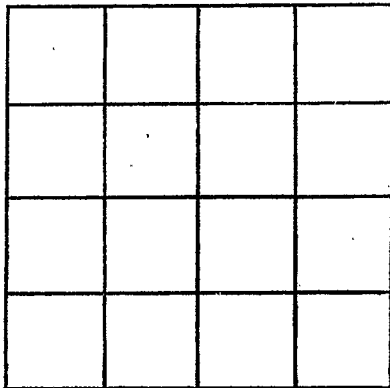

SECTION \_\_\_\_\_

Please indicate well location X.

ADDITIONAL INFORMATION

If more than one screen, show locations of each on sketch.