

SCOTT  
E 44  
7-21-72

MISSISSIPPI  
BOARD OF WATER COMMISSIONERS  
416 North State Street  
Jackson, Mississippi 39201

**CODED**

WATER WELL DRILLERS LOG

SCOTT

7/21/72 date well completed 1972  
Forest Drilling firm name  
Scott county well located

LANDOWNER:  
Curtis Johnson  
Rt 3 Nilton Miss.  
(mailing address)

description of formations encountered from to

WELL LOCATION:  
sec. 8 T. 7 N. R. 6 E  
8 miles N/W of Nilton  
(distance) (direction) (nearest town)

Brown clay	0	25
Blue clay	25	38
Sandy shale	38	40
Clay shell	40	69
Clay	69	81
Clay + mdy sand	81	110
Rock	110	112
Clay + mdy sand	112	163
Clay	163	245
Clay + mdy sand	245	280
Fine sand	280	326

WELL PURPOSE: Home  
(home, irrigation, municipal, industrial)

- WELL COMPLETION DATA:
- (1) diameter (inches) 2"
  - (2) total depth (feet) 326
  - (3) static water level (feet) 41 below top of ground.
  - (4) casing Galv. 316, (material) (depth)  
2" (size) if telescope see back.
  - (5) screen 6ft. 316 (length) (depth to top)  
2" (size) (material) Steel Gauge
  - (6) pump 1 (HP) 10 (yield gpm)  
Elect. 220V (type power)
  - (7) electric log no (yes or no)
  - (8) how well bottom plugged 2" backwash valve

**CODED**


AUG - 9 1972

MISS. BD. OF  
WATER COM. L.

DRILLERS REMARKS:

If well telescopes please sketch and show depths.

GROUND LEVEL

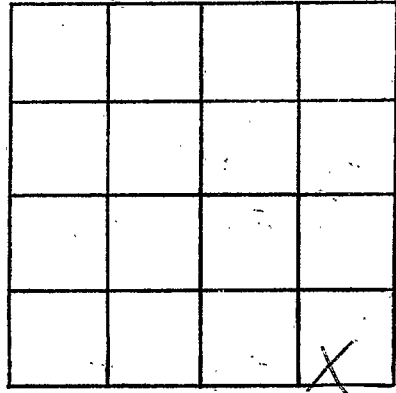

SECTION 8

Please indicate well location X.

ADDITIONAL INFORMATION

If more than one screen, show locations of each on sketch.