

SCOTT
E 45
7-27-72

MISSISSIPPI
BOARD OF WATER COMMISSIONERS
416 North State Street
Jackson, Mississippi 39201

CODED

WATER WELL DRILLERS LOG

7/27/72 19 Great Drilling Scott
date well completed firm name county well located

LANDOWNER:
Erney Johnson
Rt 3 Morton, Miss.
(mailing address)

WELL LOCATION:
sec 8 T 7 N R 6 E
8 miles NW of Morton
(distance) (direction) (nearest town)

WELL PURPOSE: Home
(home, irrigation, municipal, industrial)

- WELL COMPLETION DATA:
- (1) diameter (inches) 2"
 - (2) total depth (feet) 536
 - (3) static water level (feet) 117 below top of ground.
 - (4) casing Galv. 526
(material) (depth)
 - 2"
(size) if telescope see back.
 - (5) screen 10'4" 526
(length) (depth to top)
 - 2" 38 Gauge
(size) (material)
 - (6) pump 1 1/2 3
(HP) (yield gpm)
 - Elch 1000
(type power)
 - (7) electric log no
(yes or no)
 - (organization running log)
 - (8) how well bottom plugged 2" blue

description of formations encountered	from	to
<u>Brown Clay</u>	<u>0</u>	<u>28</u>
<u>Blue clay</u>		<u>48</u>
<u>Clay + sand</u>		<u>60</u>
<u>Clay + shells</u>		<u>81</u>
<u>Clay + ls. rock</u>		<u>102</u>
<u>Clay + Silts</u>		<u>122</u>
<u>Silt sand + Clay</u>		<u>142</u>
<u>Clay + silt sand</u>		<u>183</u>
<u>Clay</u>		<u>315</u>
<u>ls. sand + silt clay</u>		<u>327</u>
<u>Clay</u>		<u>348</u>
<u>Clay + rock</u>		<u>368</u>
<u>Clay</u>		<u>420</u>
<u>Rock</u>		<u>423</u>
<u>Clay + silt rock</u>		<u>436</u>
<u>ls. sand + silt clay</u>		<u>457</u>
<u>silt shale + silt</u>		<u>471</u>
<u>ls. sand + silt clay</u>		<u>491</u>
<u>fine sand</u>		<u>512</u>
<u>fine sand</u>		<u>536</u>

CODED


AUG -9 1972

DRILLERS REMARKS:

MSB. BO. OF
MISSISSIPPI
WATER COMMISSIONERS

If well telescopes please sketch and show depths.

GROUND LEVEL

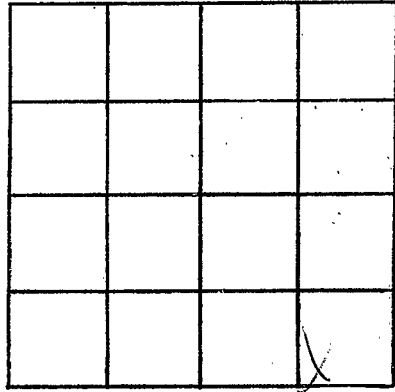

SECTION _____

Please indicate well location X.

ADDITIONAL INFORMATION

If more than one screen,
show locations of each on sketch.