

SCOTT
E 46
2-21-75

MISSISSIPPI
BOARD OF WATER COMMISSIONERS
416 North State Street
Jackson, Mississippi 39201

CODED

WATER WELL DRILLERS LOG

SCOTT

Feb-21 1975 JOHN A DAVIS
date well completed firm name county well located

LANDOWNER: DAVID HARVY

PELAHATCHIE
(mailing address)

WELL LOCATION:
sec. 24 T 7 N R 5 E
6 miles W (?) of PELAHATCHIE
(distance) (direction) (nearest town)

description of formations encountered	from	to
Red clay	6	18
Light clay	18	60
Blue	60	140
Mud	140	160
Blue	160	210

WELL PURPOSE:
(home, irrigation, municipal, industrial)

Sand streaks	210	280
--------------	-----	-----

WELL COMPLETION DATA:

- (1) diameter (inches) 2
- (2) total depth (feet) 440
- (3) static water level (feet) 190 below top of ground.
- (4) casing PVC (material), (depth) if telescope see back. (size)
- (5) screen 20' (length), (depth to top) 2" slot PVC (size) (material)
- (6) pump 3 (HP) 12 (yield gpm) E (type power)
- (7) electric log (yes or no)
- (organization running log)
- (8) how well bottom plugged PIN

Blue Rock 10"	280	285'
Sand Fine	285'	300
Rock 6"	300	315
Blue CODED	315	340
Sand Fine	340	360
Blue	360	370
Sand good	370	380
Clay Blue	380	390
Sand good	390	440


DRILLERS REMARKS:
Few small Rocks



ADD - 9 1975

If well telescopes please sketch and show depths.

GROUND LEVEL

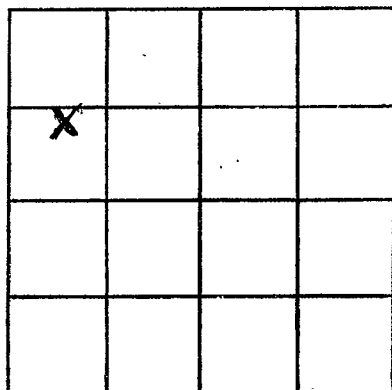

SECTION 24

Please indicate well location X.

ADDITIONAL INFORMATION

If more than one screen,
show locations of each on sketch.