

2-B


If well telescopes please sketch and show depths.

GROUND LEVEL	
0 - 20'	SAND / Clay Red.
21 - 160	Clay Hard Grey
161 - 225	Clay Sticky Grey Oily Redder in water

Total Drilled 900'
4 - 225' Bores

If more than one screen,
show location of each on sketch.

E-50

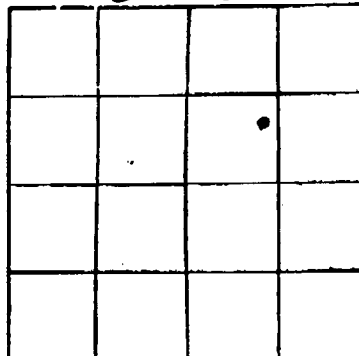

SECTION _____

Please Indicate well location X.

Pump Capacity (GPM)	No. of Stages	Setting Depth	FT.

PUMP TEST

Well yielded _____ GPM with
a drawdown of _____ ft.
after _____ hours of pumping

LOG DATA

TYPE OF LOG RUN (Circle One): No Log Run,
Electric, Gamma Ray, Density, Sonic, Neutron,
Other (Describe) _____

Name of Organization Running Log

GEOLOGIC DATA (Office Use Only)

Surface Elev.	Corelog: Unit	Unit Thickness	Depth to Top
Subs. EWL	Date	Analysis	Aquifer Test

Driller's Remarks

1 HOUR

Driller's Signature