

MISSISSIPPI DEPARTMENT OF NATURAL RESOURCES
 Bureau of Land and Water Resources
 Southport Mall
 P.O. Box 10631
 Jackson, Mississippi 39209
WATER WELL DRILLERS LOG

SCOTT
E2001
4-30-85

4-30 1985 Thomasason SCOTT CO
 date well completed firm name county well located

LANDOWNER: JAMES C THOMPSON
Markon Miss
 (mailing address)

WELL LOCATION:
 ? sec. 21 T. 4 N. R. 6 E. S. 1
6 miles NW of Markon
 (distance) (direction) (nearest town)

WELL PURPOSE:
 (home, irrigation, municipal, industrial)

WELL COMPLETION DATA:
 (1) diameter (inches) 4"
 (2) total depth (feet) 442'
 (3) static water level (feet) 120 (below/above top of ground)
 (4) casing PVC 442'
 (material) (depth)
4" if telescope see back.
 (size)
 (5) screen 20" 422'
 (length) (depth to top)
2" PVC
 (size) (material)
 (6) pump 1 12
 (HP) (yield gpm)
Electric
 (type power)
 (7) electric log NO
 (yes or no)
 (organization running log)
 (8) how well bottom plugged Screen

description of formations encountered	from	to
<u>Grey Dirt</u>	<u>0</u>	<u>6</u>
<u>Grey Chalk</u>	<u>6</u>	<u>34</u>
<u>Blue Chalk</u>	<u>34</u>	<u>138</u>
<u>Fine Grey Sand</u>	<u>138</u>	<u>170</u>
<u>Black Chalk</u>	<u>170</u>	<u>202</u>
<u>Fine Grey Sand + Chalk</u>	<u>202</u>	<u>258</u>
<u>Black Chalk</u>	<u>258</u>	<u>280</u>
<u>Grey Chalk</u>	<u>280</u>	<u>340</u>
<u>Fine Grey Sand</u>	<u>340</u>	<u>352</u>
<u>Grey Chalk</u>	<u>352</u>	<u>374</u>
<u>White Fine Sand</u>	<u>374</u>	<u>442</u>


RECEIVED
 MAY 14 1985

DRILLERS REMARKS:

Department of Natural Resources
 Bureau of Land & Water Resources

If well telescopes please sketch and show depths.

GROUND LEVEL

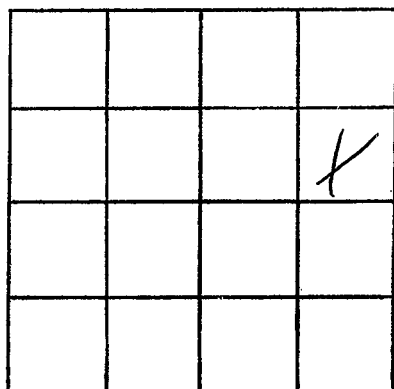

SECTION _____

Please indicate well location X.

ADDITIONAL INFORMATION

If more than one screen,
show locations of each on sketch.