

MISSISSIPPI DEPARTMENT OF NATURAL RESOURCES

Bureau of Land and Water Resources

Southport Mall

P.O. Box 10631

Jackson, Mississippi 39209

WATER WELL DRILLERS LOG

Scott
E 2002

May 23 1988 F.M. Bud Gresswell Scott
date well completed firm name county well located

LANDOWNER:
Jim Walter Homes, Inc.
JACKSON, MS.
(mailing address)

WELL LOCATION:
sec. 32 T 7 N R 6 E
6 miles North of Morton
(distance) (direction) (nearest town)

WELL PURPOSE: home
(home, irrigation, municipal, industrial)

WELL COMPLETION DATA:

(1) diameter (inches) 4

(2) total depth (feet) 310

(3) static water level (feet) 110 below top of ground.

(4) casing PVC 300 (material) (depth)
4 (size) if telescope see back.

(5) screen 10 300 (length) (depth to top)
4 PVC (size) (material)

(6) pump 1 20 (HP) (yield gpm)
(type power)

(7) electric log no (yes or no)
(organization running log)

(8) how well bottom plugged Sand shell

description of formations encountered	from	to
	Surface	0
Yellow Clay	25	40
Meadow Branch	40	60
Shale	60	150
Sand	150	230
Shale	230	265
Sand	265	310

RECEIVED


JUN 15 1988

Department of Natural Resources
Bureau of Land and Water Resources

DRILLERS REMARKS:

If well telescopes please sketch and show depths.

GROUND LEVEL

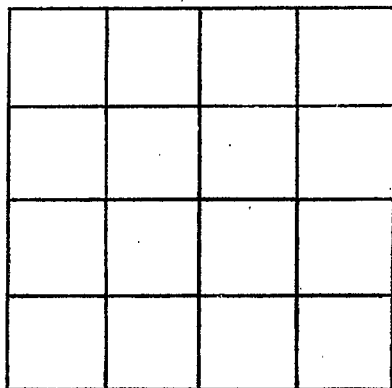

SECTION _____

Please indicate well location X.

ADDITIONAL INFORMATION

If more than one screen,
show locations of each on sketch.