

MISSISSIPPI DEPARTMENT OF ENVIRONMENTAL QUALITY
Bureau of Land and Water Resources

P. O. Box 10631
Jackson, MS 39289-0631
WATER WELL DRILLERS LOG

COUNTY WELL LOCATED SCOTT	
WELL NUMBER E	CODED
DATE WELL COMPLETED 2005 7-2-91	

PERMIT NUMBER
NAME OF DRILLING FIRM GARDNER DRILLING
SEBASTIAN, MS 39351

NAME & MAILING ADDRESS OF LANDOWNER B.C. RODGERS P.O. Box A MORTON, MS. 39117		
WELL LOCATION: SEC	TOWNSHIP	RANGE
32	7	N 6 E
DISTANCE	DIRECTION	NEAREST TOWN
12 Miles	N	of MORTON
OTHER LANDMARK		
WELL PURPOSE: Home, Irrigation, Municipal, Industrial, Fish Pond, etc. POULTRY FARM		

PUMP DATA		
PUMP TYPE (Circle One): <u>Submersible</u> Turbine, Jet, Flowing Well, Other (Describe) _____		
POWER TYPE (Circle One): <u>Electric</u> , Tractor, Diesel, Gasoline, Butane, Other (Describe) _____ H/P _____		
Pump Capacity (GPM) 18	No. of Stages 12	Setting Depth 70 FT.
PUMP TEST		
Well yielded 40 GPM with a drawdown of 10 ft. after 1 hours of pumping		

WELL DATA		
Well Depth 280'	Casing Diameter (In.) 4"	Casing Length (Ft.) 20
Type of Casing PVC	Hole Depth 280	Depth to Static Water Level 43'
TYPE OF COMPLETION: (Circle One or More): Gravel Packed, Underreamed, <u>Telescoped</u> , Natural Development, Open Hole, Other (Describe) 4x2		
Top of Lap Pipe or Reduction in Casing 160 FEET IF TELESCOPED OR MORE THAN ONE SCREEN: USE BACK PAGE		

LOG DATA	
TYPE OF LOG RUN (Circle One): Electric, Gamma Ray, Density, Sonic, Neutron, Other (Describe) <u>No Log Run</u>	
Name of Organization Running Log	

SCREEN DATA		
Diameter - Inches 2	Length - Feet 20	Slot Size - Inches 8
Screen Type PVC RIB		Depth to Bottom - Feet 280

GEOLOGIC DATA (Office Use Only)			
Surface Elev.	Geologic Unit	Unit Thickness	Depth to Top
Subs. SWL	Date	Analysis	Aquifer Test
Driller's Remarks			

DESCRIPTION OF FORMATIONS ENCOUNTERED	FROM	TO
CLAY	0	15
SAND	15	35
LIGNITE	35	43
ROCK	43	50
SAND	50	70
SAND + CLAY Ledges	70	135
ROCK	135	136
CLAY + SAND ledges	136	210
SAND	210	280

FORMATIONS (continued)


DEC 03 1991

Dept. of Environmental Quality
Bureau of Land & Water Resources

IF MORE SPACE IS NEEDED, USE BACK

If well telescopes please sketch and show depths.

GROUND LEVEL

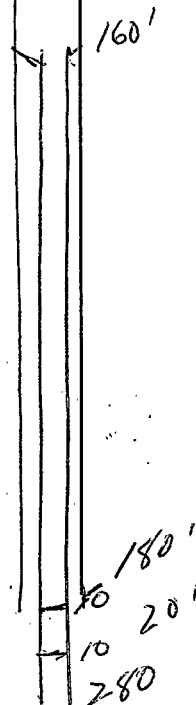

If more than one screen, show location of each on sketch.

			X

SECTION 32

Please indicate well location X.

ADDITIONAL INFORMATION

Lined area for additional information.