

9-27-63

WATER WELL DRILLERS LOG

V

Date: 9/27, 1963, Driller: Forest Delphew County Scott
 (Name)

(1) Owner of Land: Jack Shannon
 (Name)
Rt. 1, Lena, Miss.
 (Address)
 711 1/2

(2) Location: 1/4, 1/4, Sec. 2 T. R
6 miles West of Hellboro
 (distance) (direction) (Nearest Town)

(3) Topography: _____
 (Hilly) (Flat) (Level)

(4) Purpose of Well: Home
 (Domestic Irrigation
 Municipal, Industrial, Other)

Description & Color of Materials Sand, Clay, Red Clay, Shell, etc.	Thick- ness Feet	Depth Feet
Brown Clay	0	22
Clay + Sand		34
Clay + Shale sand		42
Clay		72
Clay + Moly sand		82
Clay		102
Clay + Shale moly sand		112
Clay		152
Clay + Sh. Fine sand		182
Fine sand + Sh. Clay		192
Fine sand		205
Clay + Shale sand		212
Fine sand		222
Clay + Shale sand		242
Fine sand		262

Information upon completion of well:

(1) Diameter 2 inches.

(2) Total Depth 262 feet.

(3) Water Level 38 feet below top of ground.

(4) Cased to 252, Size 2"


(5) Screen: Size 2", Length 10ft

(6) Were any formations sealed against pollution?
 _____ yes, no.

If YES depth of formation _____

Why _____

Drillers Remarks: _____

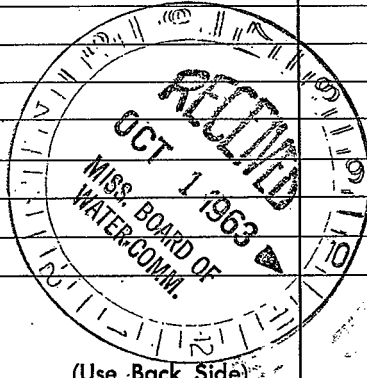

Well No.

