

SCOTT MISSISSIPPI BOARD OF WATER COMMISSIONERS

F 3

B T

4-10-65

WATER WELL DRILLERS LOG

Date: 4/10, 1965, Driller: Trust Drilling County Scott
 (Name)


(1) Owner of Land: L. O. Reeves
 (Name)
Rt 3 Forest Drive
 (Address)
 (2) Location: 1/4, 1/4, Sec. 16 T R
6 miles West of Nicheland
 (distance) (direction) (Nearest Town)
 (3) Topography: _____
 (Hilly) (Flat) (Level)
 (4) Purpose of Well: Home
 (Domestic Irrigation
 Municipal, Industrial, Other)

Description & Color of Materials Sand, Clay, Red Clay, Shell, etc.	Thick- ness Feet	Depth Feet
Brown Clay		27
Blue Clay		52
lime Rock		54
Blue Clay		62
Clay + body shell		82
Clay		132
Clay + shells & mly sand		162
mly sand + clay		172
lime Rock + soft clay		182
Clay		192
fine sand + clay		212
Clay + shells & mly sand		242
fine sand + shells & clay		252
Clay		259
fine sand		267

Information upon completion of well:

(1) Diameter 2 inches.
 (2) Total Depth 277 feet.
 (3) Water Level 69 feet below top of ground.
 (4) Cased to 267, Size 2"
 (5) Screen: Size 2", Length 10ft.
 (6) Were any formations sealed against pollution?
 _____ yes, ✓ no.

If YES depth of formation _____
 Why _____
 Drillers Remarks: _____

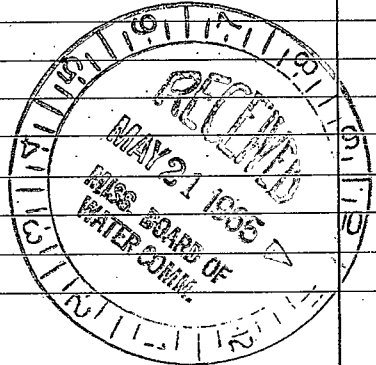

(Use Back Side)

Well No.

