

MISSISSIPPI  
BOARD OF WATER COMMISSIONERS  
416 North State Street  
Jackson, Mississippi 39201

WATER WELL DRILLERS LOG

7-20 1967 Forest Drilling Scott  
date well completed firm name county well located

LANDOWNER: Lulu Bannor

description of formations encountered

from to

Rt.  
Lenox Miss  
(mailing address)

<u>Red Clay</u>	<u>0</u>	<u>9</u>
<u>Clay + 5th Sand</u>		<u>61</u>
<u>Clay</u>		<u>98</u>
<u>Fine Sand</u>		<u>102</u>
<u>Fine Sand + 5th Clay</u>		<u>122</u>
<u>Fine Sand</u>		<u>143</u>

WELL LOCATION

sec. 9 T. 8 N. R. 6 E. 7 ?  
S. W.  
(4) - 3 1/2 miles NE of Richlow  
(distance) (direction) (nearest town)

WELL PURPOSE: Home  
(home, irrigation, municipal, industrial)

WELL COMPLETION DATA:

(1) diameter (inches) 2"  
(2) total depth (feet) 142  
(3) static water level (feet) \_\_\_\_\_ below above top of ground.

(4) casing Galv., 137,  
(material) (depth)  
2"  
(size) if telescope see back.

(5) screen 5ft, 137  
(length) (depth to top)  
2 1/2, #80 Gauge  
(size) (material)


(6) pump \_\_\_\_\_ (HP) \_\_\_\_\_ (yield gpm)

(7) electric log No.  
(yes or no)

(organization running log)

(8) how well bottom plugged brush  
well

DRILLERS REMARKS:

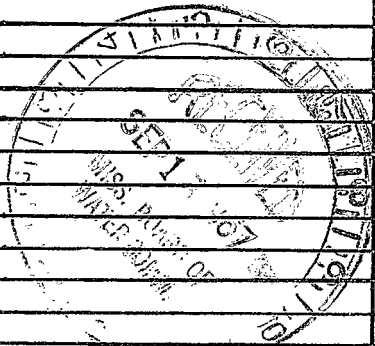

If well telescopes please sketch and show depths.

GROUND LEVEL

			X

SECTION 9

Please indicate well location X.

ADDITIONAL INFORMATION

If more than one screen,  
show locations of each on sketch.