

SCOTT  
R5  
3-68

MISSISSIPPI  
BOARD OF WATER COMMISSIONERS  
416 North State Street  
Jackson, Mississippi 39201

WATER WELL DRILLERS LOG

March 19 1968 Wilkerson Drilling SCOTT  
date well completed firm name county well located

LANDOWNER: Athy D. Noel

description of formations encountered

from to

CLIFTON, MISS

yellow clay

0 30

sand

30 33

blue clay

33 109

Rock

109 111

blue shale

111 119

brown shale

119 150

sand

150 220

fine sand

220 250

(mailing address)

WELL LOCATION:


sec. 3 T. 7 N. R. 7 E.  
5 miles W of Hillsboro  
(distance) (direction) (nearest town)

WELL PURPOSE: home  
(home, irrigation, municipal, industrial)

WELL COMPLETION DATA:

- (1) diameter (inches) 2
- (2) total depth (feet) 215
- (3) static water level (feet) 40 below above top of ground.
- (4) casing Galv., 210,  
(material) (depth),  
2"  
(size) if telescope see back.
- (5) screen 5, 210,  
(length) (depth to top)  
2, brass,  
(size) (material)
- (6) pump 1 1/2, 16,  
(HP) (yield gpm)  
5/16  
(type power)
- (7) electric log NO  
(yes or no)  
(organization running log)
- (8) how well bottom plugged 2-2" R.W.

DRILLERS REMARKS:

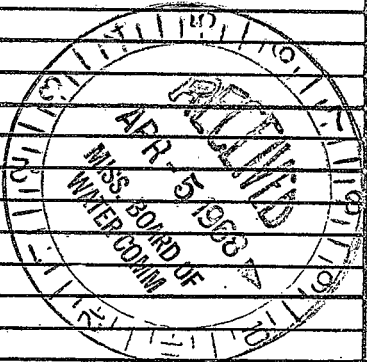

If well telescopes please sketch and show depths.

GROUND LEVEL

+			

SECTION 3

Please indicate well location X.

ADDITIONAL INFORMATION

If more than one screen, show locations of each on sketch.