

SCOTT  
F 7  
8-67

MISSISSIPPI  
BOARD OF WATER COMMISSIONERS  
416 North State Street  
Jackson, Mississippi 39201

WATER WELL DRILLERS LOG

8-12 1967 COMENS DRILLING CO. SCOTT  
date well completed firm name county well located

LANDOWNER: Glover Bell  
Forest Route 3th  
Miss  
(mailing address)

description of formations encountered	from	to
	<del>Clay</del> Clay	0
Silt + Clay	60	170
Silt + Clay shell	170	200
Sand of loam		
Gravel	200	215


WELL LOCATION:  
sec. 12 T. 7 N R. 7 E  
S W  
3 miles West of Hindsboro  
(distance) (direction) (nearest town)

WELL PURPOSE: Home  
(home, irrigation, municipal, industrial)

WELL COMPLETION DATA:


- (1) diameter (inches) 2"
- (2) total depth (feet) 215
- (3) static water level (feet) 65 below above top of ground.
- (4) casing 2" 211  
(material) (depth)  
2" if telescope see back.  
(size)
- (5) screen 5'   
(length) (depth to top)  
 (size) (material)
- (6) pump    
(HP) (yield gpm)  
 (type power)
- (7) electric log No  
(yes or no)  
 (organization running log)
- (8) how well bottom plugged

DRILLERS REMARKS:

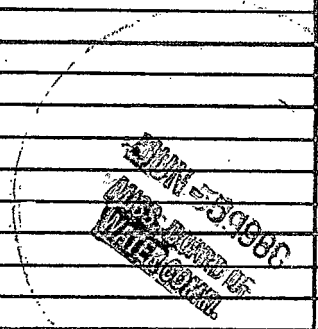

If well telescopes please sketch and show depths.

GROUND LEVEL

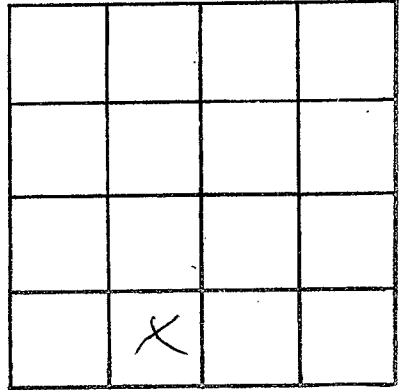

SECTION \_\_\_\_\_

Please indicate well location X.

ADDITIONAL INFORMATION

If more than one screen,  
show locations of each on sketch.