

ELog#102

SCOTT
F10
7-1-71

MISSISSIPPI
BOARD OF WATER COMMISSIONERS
416 North State Street
Jackson, Mississippi 39201

Coded

WATER WELL DRILLERS LOG

7-1 1971 *Verest Drilling Service* *Scott*
date well completed firm name county well located

LANDOWNER: *Stockdale Trail*

description of formations encountered	from	to
<i>yellow clay</i>	0	18
<i>chalky clay</i>	18	72
<i>sand, shell & clay</i>	72	84
<i>fine sand & shale</i>	84	104
<i>Brown clay</i>	104	124
<i>soft brown clay & sand</i>	124	144
<i>fine sand & sh. shale</i>	144	164
<i>fine sand</i>	164	180
<i>fine sand & sh. shale</i>	180	244
<i>fine sand</i>	244	264
<i>fine sand & sh. shale</i>	264	284
<i>silt & clay</i>	284	298
<i>fine sand & sh. of shale</i>	298	329
<i>shale</i>	329	364
<i>shale & sh. of rock</i>	364	404
<i>shale</i>	404	424
<i>shale & sh. of rock</i>	424	444
<i>shale</i>	444	450
<i>fine sand & sandy shale</i>	450	480
<i>sandy clay</i>	480	594
<i>fine sand</i>	594	614
<i>shale</i>	614	746
<i>shale & sh. rock</i>	746	767
<i>shale</i>	767	890
<i>Rock</i>	890	895
<i>shale</i>	895	904
<i>Rock</i>	904	906
<i>shale</i>	906	914
<i>shale & sh. rock</i>	914	977
<i>Rock & sh. shale</i>	977	992

Camp Base #2
Pearl River Basin Div. Dist.
(mailing address)

WELL LOCATION:
sec. 23 T. 7 N R. 7 E
miles (distance) of (direction) of (nearest town)

WELL PURPOSE: *municipal*
(home, irrigation, municipal, industrial)

WELL COMPLETION DATA:

- (1) diameter (inches) 4" 2 1/2"
- (2) total depth (feet) 623 ft
- (3) static water level (feet) 175 below top of ground.
- (4) casing galv. (material) 233' - 4" (depth) 2 1/2" (size) If telescope see back.
- (5) screen 20' (length) 6 1/2' (depth to top)
2" #.008, stainless steel (size) (material)
- (6) pump 2 HP (HP) 900 GPH (yield gpm)
Electric's (type power)
- (7) electric log yes (yes or no)
Miss. Geo. (organization running log)
- (8) how well bottom plugged 8' - 2"
tail pipe

2 1/2" 233' 695'


AUG 23 1971

DRILLERS REMARKS:

MISS. BD. OF
WATER COMM.

If well telescopes please sketch and show depths.

GROUND LEVEL

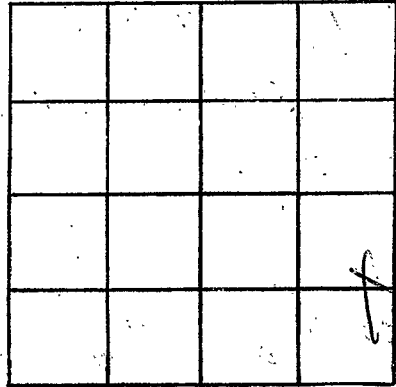

SECTION 29

Please indicate well location X.

ADDITIONAL INFORMATION

If more than one screen, show locations of each on sketch.