

SCOTT
F 11
5-15-73

MISSISSIPPI
BOARD OF WATER COMMISSIONERS
416 North State Street
Jackson, Mississippi 39201

CODED

WATER WELL DRILLERS LOG

5-15
date well completed

1973 Wilkerson Drilling
Lake Miss firm name

Scott County
county well located

LANDOWNER: Mr. Dewitt Simmons

description of formations encountered

from to

Wilcox St

Red clay + sand

0 30

Forest Miss

Rock

30 32

(mailing address)

Blue clay + hard clay

32 80

WELL LOCATION:

" "

80 120

sec. 35 T 7 N R 7 E

SAND

120 135

6 miles N.W. of Forest
(distance) (direction) (nearest town)

CLAY + SAND

135 160

SAND

160 226

WELL PURPOSE: Farm + Chicken Farm
(home, irrigation, municipal, industrial)

WELL COMPLETION DATA:

- (1) diameter (inches) 4"
(2) total depth (feet) 226'
(3) static water level (feet) 78' below above top of ground.
(4) casing Sch 40 Pipe 2 1/2" (material) 216' (depth)

 if telescope see back.
(size)

- (5) screen 10' (length) 226' (depth to top)
2" (size) Stainless Steel (material)

- (6) pump 1 (HP) 24 (yield gpm)
Elec. (type power)

- (7) electric log NO (yes or no)

(organization running log)

- (8) how well bottom plugged 2" Bull


CODED

JUN 15 1973

DRILLERS REMARKS:

If well telescopes please sketch and show depths.

GROUND LEVEL

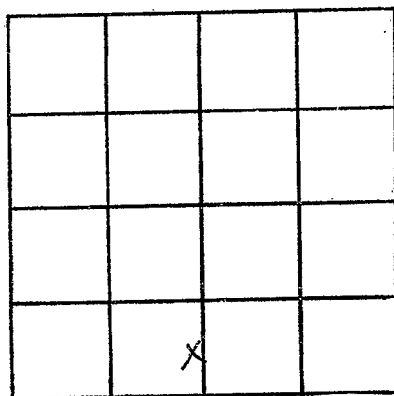

SECTION 35

Please indicate well location X.

ADDITIONAL INFORMATION

If more than one screen,
show locations of each on sketch.