

6

SCOTT  
F12  
5-19-81

MISSISSIPPI  
BOARD OF WATER COMMISSIONERS  
416 North State Street  
Jackson, Mississippi 39201

WATER WELL DRILLERS LOG

CODED

5-19-81 19 Tom Hulph Scott  
date well completed firm name county well located

LANDOWNER: Walter R. P. 1

description of formations encountered

from to

Collins Petroleum Co  
PO Box 1787 Natchez, Miss  
(mailing address)

Lophoc 0 7  
Gravel 7 80  
Sand 80 290  
Clay 290 370  
Sand 370 400

WELL LOCATION:


sec 31 T 7 N R 7 E  
S W  
2 miles NE of Walter  
(distance) (direction) (nearest town)

1705' S + 1977' W of NE/Cor.  
OF Sec. 31

WELL PURPOSE: Oil Well  
(home, irrigation, municipal, industrial)

WELL COMPLETION DATA:


- (1) diameter (inches) 3"
- (2) total depth (feet) 400
- (3) static water level (feet) 175 below top of ground
- (4) casing Steel 300ft  
(material) (depth)
- n/a if telescope see back.  
(size)
- (5) screen 40, 360  
(length) (depth to top)  
4", Steel Slot  
(size) (material)
- (6) pump air 70  
(HP) (yield gpm)  
air  
(type power)
- (7) electric log no  
(yes or no)  
n/a  
(organization running log)
- (8) how well bottom plugged steel

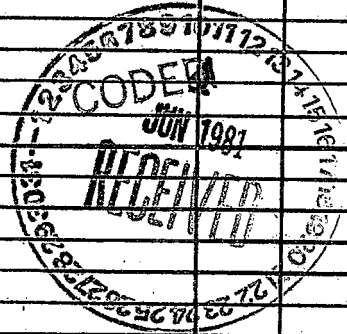

DRILLERS REMARKS:

If well telescopes please sketch and show depths.

GROUND LEVEL

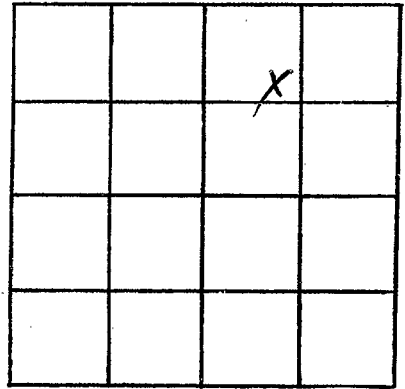

SECTION 31

Please indicate well location X.

ADDITIONAL INFORMATION

If more than one screen,  
show locations of each on sketch.